

Mandrelled conduit 6/15/23
Signed off by Inspector Aaron Elswick 6/15/23

Installed all utility conduits to the future pole locations per City of Gardena direction with approvals of all utilities

As Built



SCALE 1" = 30'

PREPARED BY:



REVISIONS

NO.	DESCRIPTION	DATE	APPROVED

B.M.:
-
-
-

CITY OF GARDENA

DEPARTMENT OF PUBLIC WORKS - ENGINEERING

SHEET TITLE


2QS-RULE 20C, UTILITY UNDERGROUND

SOUTHERN CALIFORNIA EDISON

DESIGNED BY	INITIAL	DATE	APPROVED BY:
DRAWN BY	-	-	1/30/23 Allan Riggs
CHECKED BY	-	-	DATE
SHT. 2 OF 6			DIRECTOR OF PUBLIC WORKS
DWG. NO. 5-2611			

FILE PATH: C:\USERS\JESPINOZA\DESKTOP\2QS-RULE 20C UG\PDF SHEETS\COG-TITLE BLOCK_UG_PDF.DWG, PLOT TIME: 1/27/2023 10:13:40 AM

TD2030934
RELATED W/O
TD2035520-PREV MAINT
TD1930432-OH REMOVAL

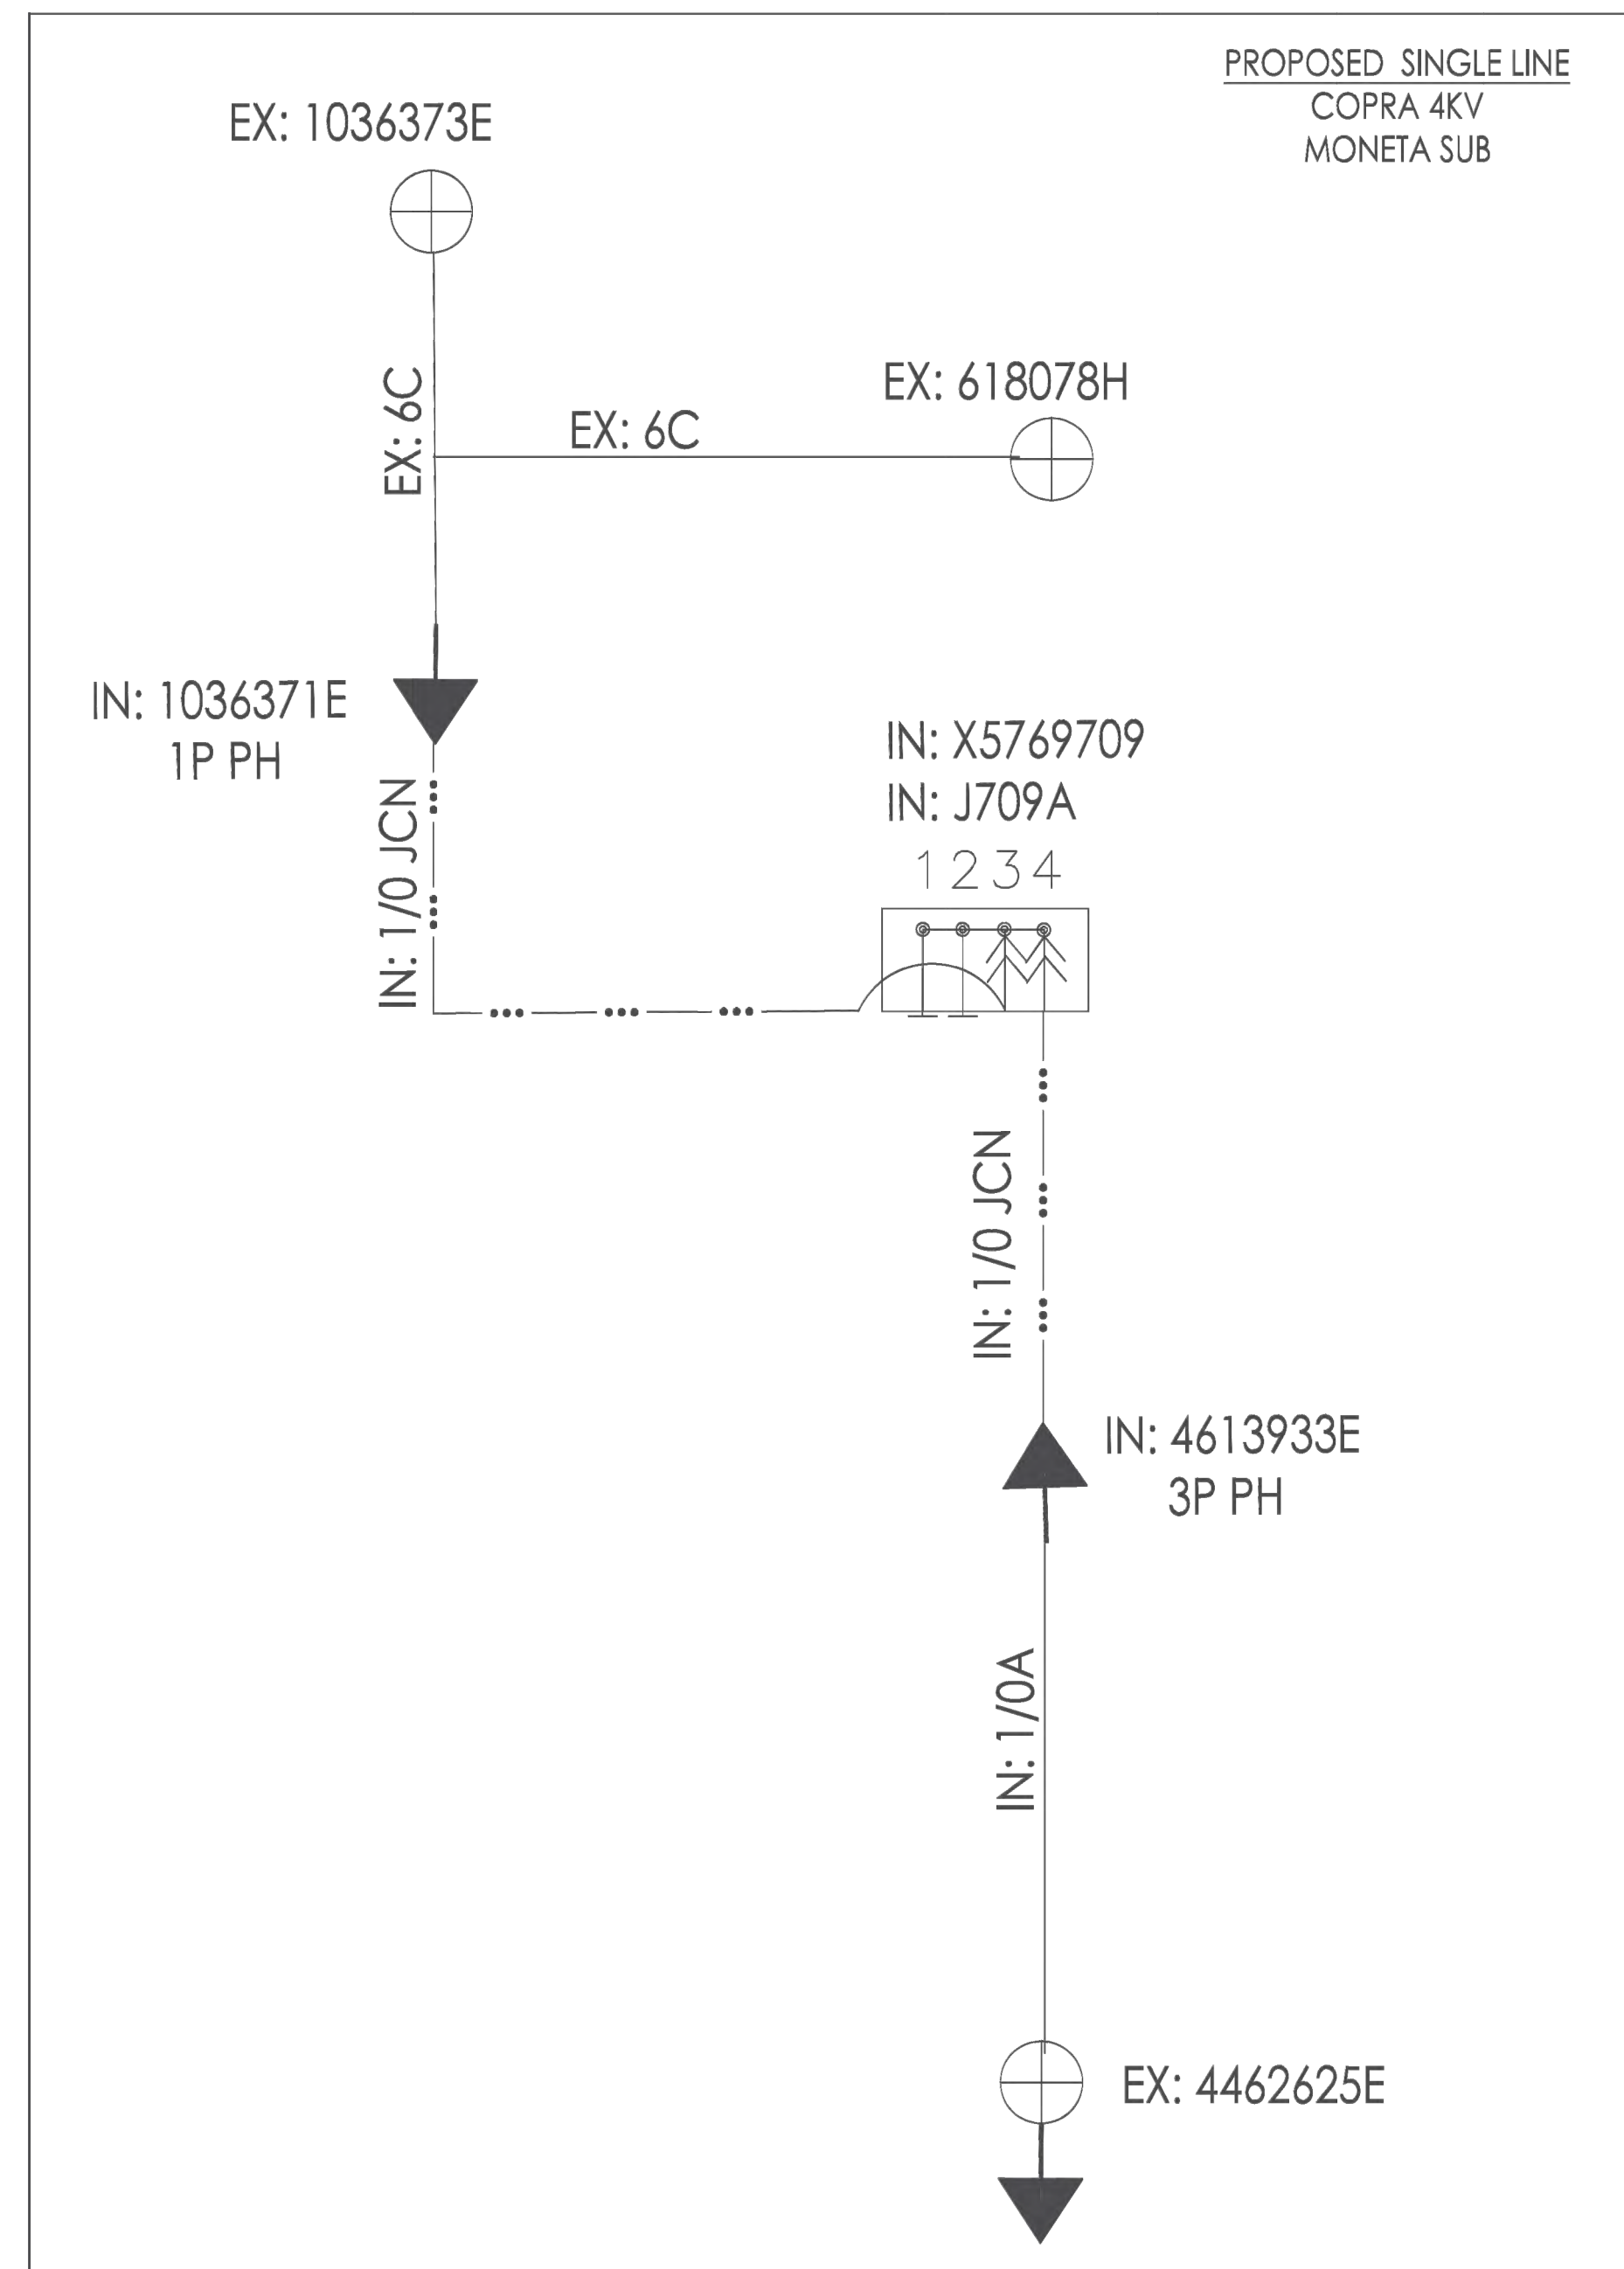

As Built

[illegible]

R E V I S I O N S				CITY OF GARDENA DEPARTMENT OF PUBLIC WORKS - ENGINEERING			
NO.	DESCRIPTION	DATE	APPROVED	SHEET TITLE 2QS-RULE 20C, INSTALL UTILITY UNDERGROUND SOUTHERN CALIFORNIA EDISON			
B.M.: _ _				INITIAL	DATE	APPROVED BY:	
				DESIGNED BY	-	1/30/23	
				DRAWN BY	-	DATE	
				CHECKED BY	-	DIRECTOR OF PUBLIC WORKS	
				SHT.	4	OF	6
				D.W.G. NO.		5-2611	

FILE PATH: C:\USERS\JESPINOZA\DESKTOP\2QS-RULE 20C IUG\PDF SHEETS\COG-TITLE BLOCK IUG.PDF.DWG, PLOT TIME: 1/27/2023 10:32:00 AM

Inspector
Jose Ortiz | Construction Coordinator | (310) 429-3459
1529 Valley Dr. | Hermosa Beach, Ca 90254

CITY OF GARDENA
PUBLIC WORKS DEPARTMENT
1717 WEST 162ND STREET
GARDENA, CA 90247-3778

CONTACT INFO:
SCOTT GOBBLE
UTILITY CONSULTANT
(310) 378-4818

DOWNSIZE AND REPLACE EXISTING COPPER CABLE IN TO
 UNDERGROUND CONDUIT TO BE PLACED BY THE CUSTOMER.
 REMOVE EXISTING POLE. PLACE NEW DOWN GUY ON AN
 ADJACENT POLE. OBTAIN JPA AND EASEMENT FOR NEW CONDUIT.



SCALE 1" = 30'



DIAL TOLL FREE
1-800-422-4133

AT LEAST TWO DAYS
BEFORE YOU DIG

UNDERGROUND SERVICE ALERT OF SOUTHERN CALIFORNIA



R E V I S I O N S				CITY OF GARDENA			
				DEPARTMENT OF PUBLIC WORKS - ENGINEERING			
				SHEET TITLE			
				2QS-RULE 20C, UTILITY UNDERGROUND			
				CHARTER COMMUNICATION			
				DESIGNED BY	INITIAL	DATE	APPROVED BY: 1/30/23 Allan Rigg DATE SHT. 6 OF 6 DWG. NO. 5-2611
B.M.: _				DRAWN BY	-	-	
				CHECKED BY	-	-	

FILE PATH: C:\USERS\ESPINOZA\DESKTOP\20S-RULE 20C UG\PDF SHEETS\COG-TITLE BLOCK_UG_PDF.DWG, PLOT TIME: 1/27/2023 10:43:56 AM