

ELEVATION - WALL NOTCHED SKATE STOPS AND REVEALS SCALE: 1-1/2" = 1'-0"

- POURED-IN-PLACE CONCRETE WALL AND CAP WITH 'TOP CAST' ETCH CODE NO.

  05 FINISH, OR APPROVED EQUAL, ALL SIDES. ALL CAP CORNERS AND EDGES TO


  SINGLE BLADE SAWCUT CONTROL JOINT AT REVEAL JOINTS, 1/3 DEPTH OF CONCRETE CAP. 05 FINISH, OR APPROVED EQUAL, ALL SIDES. ALL CAP CORNERS AND EDGES TO RECEIVE A  $\frac{1}{2}$ " TOOLED RADIUS. SLOPE TOP OF WALL 1% MINIMUM TOWARDS PLANTER OR DIRECTION OF PAVING SURFACE FLOW.
- 2 CONTINUOUS EXPANSION JOINT. SEE DETAIL 3, SHEET L-2.01.
- ADJACENT CONCRETE PAVING. SEE DETAIL 1, SHEET L-2.01 AND LANDSCAPE CONSTRUCTION PLAN, SHEET L-1.01 FOR LOCATIONS.
- 4 FINISH GRADE. SEE CIVIL PLANS.
- 5 POURED-IN-PLACE CONCRETE FOOTING WITH (4) #5 CONTINUOUS REBAR, TOP AND BOTTOM, PER STRUCTURAL ENGINEER AS SHOWN THIS DETAIL.
- 6 90% MINIMUM COMPACTED, MOISTURE-CONDITIONED SUBGRADE PER GEOTECHNICAL REPORT. SEE SPECIFICATIONS.
- 3/4" WIDE X 1/2" DEEP CONCRETE REVEAL, CONTINUOUS ACROSS FACE AND SIDES OF CONCRETE CAP. SPACED AS SHOWN ON ENLARGEMENT.
- 8 3/4" WIDE x 1/2" DEEP SKATE STOPPER NOTCH. CENTERED BETWEEN REVEAL JOINTS, BOTH SIDES OF CONCRETE CAP.

- 10 SAWCUT CONTROL JOINT DOWN FACE OF WALL, BOTH SIDES PER CIVIL **ENGINEERS DETAILS.**
- 11) PROVIDE CONTINUOUS MIRADRI 860 WATERPROOF MEMBRANE AND MIRADRAIN 6200 DRAINAGE COMPOSITE BY MIRAFI INC., OR APPROVED EQUAL. INSTALL PER MANUFACTURER'S SPECIFICATIONS. CONTACT: JAMES
- PROVIDE CONTINUOUS 12" SQ. 3/4" CRUSHED AGGREGATE. PROVIDE CONTINUOUS FILTER FABRIC WRAP.
- (13) CONTINUOUS PVC DRAINLINE SEE CIVIL PLANS.
- #4 REBAR AT 16" VERTICAL, EACH FACE.


HEIDT AND ASSOCIATES (818)248-9677.

15) #4 REBAR AT 10" HORIZONTAL, EACH FACE. (16) #4 REBAR AT 24" O.C.

- A CONTRACTOR TO PROVIDE COLOR / FINISH SAMPLE FOR REVIEW AND APPROVAL PRIOR TO FABRICATION.
  - B CONTRACTOR SHALL PROVIDE 6' X 6' MOCK OF WALL AND CAP WITH SKATEBOARD NOTCHES AND DEEP TOOL SCORE JOINTS FOR REVIEW AND APPROVAL BY LANDSCAPE ARCHITECT PRIOR TO CONSTRUCTION.
  - C CONTRACTOR SHALL PROVIDE DEEP TROWEL SCORE JOINTS ACROSS FACE AND TOP OF WALL WHERE SHOWN ON PLANS AND AT ALL CORNER CONDITIONS, TYPICAL.
  - D SEE GEOTECHNICAL REPORT (PAVEMENT RECOMMENDATIONS) FOR CONCRETE TYPE AND

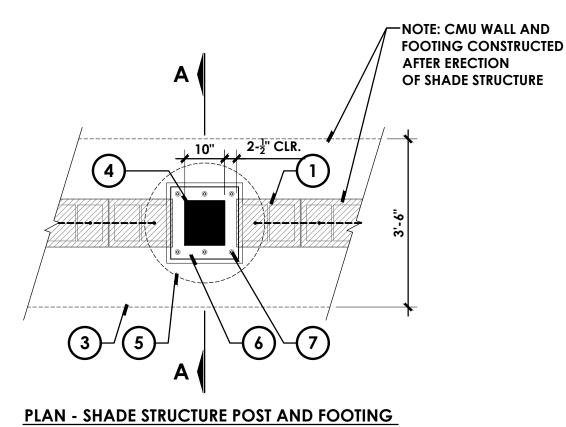

SCALE: 1/2" = 1'-0"

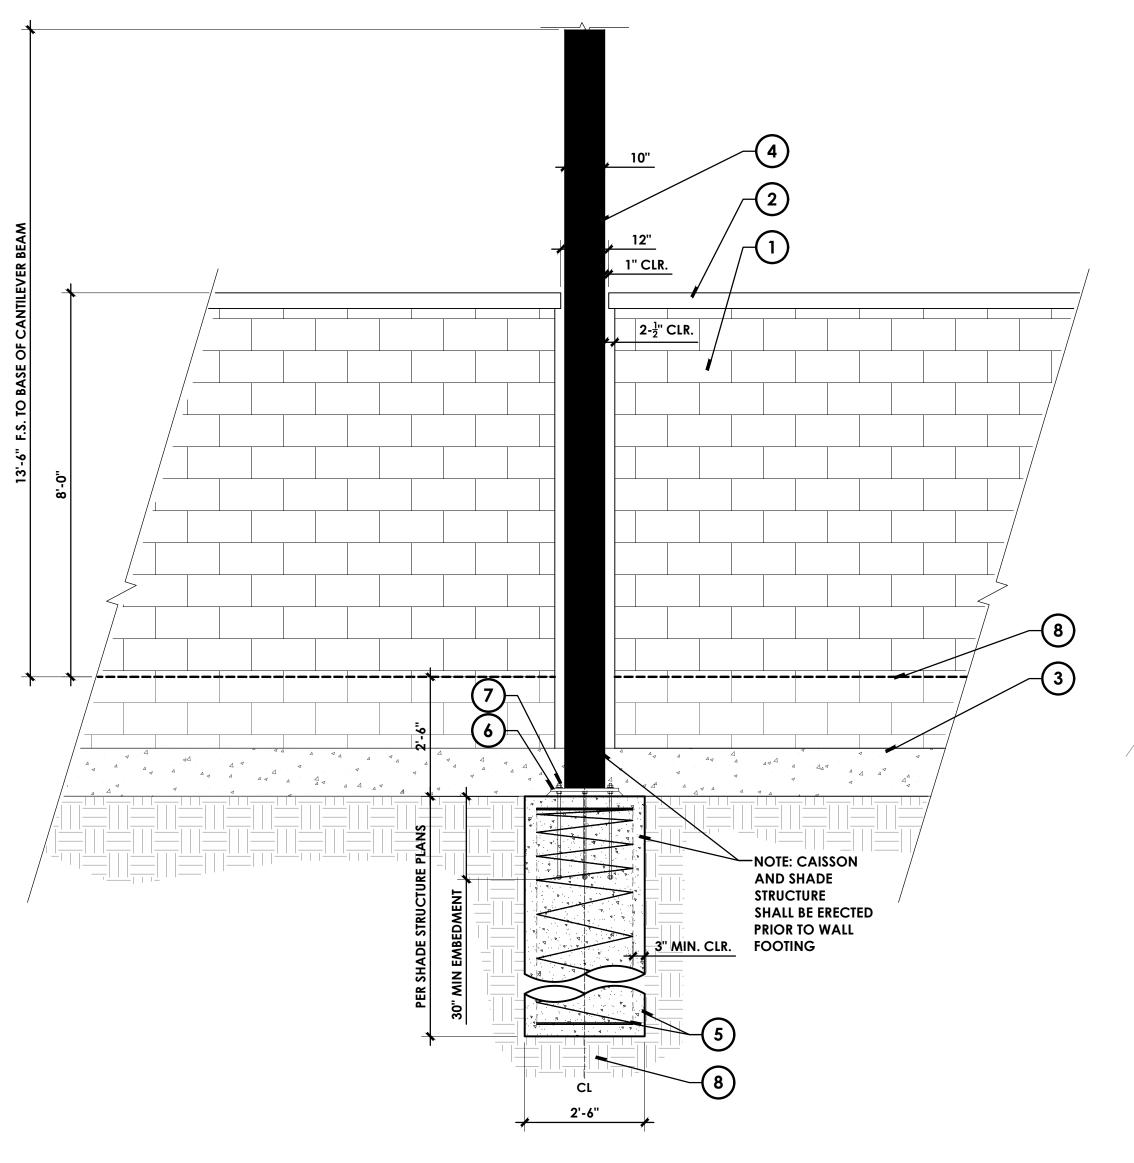

FRONT ELEVATION - SHADE STRUCTURE POST AND FOOTING SCALE: 1/2" = 1'-0"

**AND SHADE** STRUCTURE SHALL BE ERECTED PRIOR TO WALL "MIN. CLR. FOOTING

SECTION 'A-A' - SHADE STRUCTURE POST AND FOOTING **SCALE:** 1/2" = 1'-0"

- 8' PERIMETER CONCRETE BLOCK WALL. SEE DETAIL 6, SHEET L-2.01 AND CONSTRUCTION PLAN, SHEET L-1.02 FOR LOCATIONS.
- POURED-IN-PLACE CONCRETE CAP ON BLOCK WALL. SEE DETAIL 6, SHEET L-2.01.
- 3 CONCRETE BLOCK WALL FOOTING. SEE DETAIL 6, SHEET L-2.01.
- (4) 10" SHADE STRUCTURE POST. SEE USA SHADE SHADE STRUCTURE ENGINEERING PLANS AND DETAILS, SHEET L-2.12 AND L-2.16.
- 5 2'-6" DIA. POURED-IN-PLACE CONCRETE SHADE STRUCTURE FOOTING TO OCCUR BELOW CONCRETE BLOCK WALL FOOTING. SEE USA SHADE SHADE STRUCTURE ENGINEERING PLANS, SHEETS L-2.13 AND L-2.17, FOR DEPTH AND REINFORCEMENT. SEE STRUCTURAL CALCULATIONS PREPARED BY STATE OF CALIFORNIA LICENSED STRUCTURAL ENGINEER.
- (6) 17" SQ. BASE PLATE. SEE SEE USA SHADE DETAIL, SHEETS L-2.13 AND L-2.17.
- SIX 1-1/4" X 36" ANCHOR BOLTS. HEAVY HEX. NUTS (3), FLAT WASHER (2) LOCK WASHER (F1554 GR.55 GALVANIZED). SEE USA SHADE DETAIL, SHEETS L-2.13 AND L-2.17.

CONCRETE MASONRY BLOCK PERIMETER WALL AT SHADE STRUCTURES

- 8) 90% MINIMUM COMPACTED, MOISTURE-CONDITIONED SUBGRADE PER GEOTECHNICAL REPORT. SEE SPECIFICATIONS.
- 9 FINISH GRADE. SEE CIVIL PLANS.
- 10 ADJACENT CONCRETE PAVING PER DETAIL 2, SHEET L-2.01.

- A VERIFY FIELD CONDITIONS PRIOR TO CONSTRUCTION.
- B CONTRACTOR TO PROVIDE COLOR / FINISH SAMPLE FOR REVIEW AND APPROVAL PRIOR TO FABRICATION.
- SEE GEOTECHNICAL REPORT (PAVEMENT RECOMMENDATIONS) FOR CONCRETE TYPE
- D CAISSON AND SHADE STRUCTURE SHALL BE ERECTED PRIOR TO THE WALL FOOTING.
- E SHADE STRUCTURE AND FOOTING DESIGN SHALL IMPART OR TRANSFER NO LOADS OR FORCES ON TO ADJACENT CONSTRUCTIONS. (I.E. WALL FOOTING, WALL CAP, ETC.)

# POURED-IN-PLACE CONCRETE PLANTER LOW WALL

UNDERGROUND SERVICE ALERT OF SOUTHERN CALIFORNIA

**BASIS OF BEARINGS:** 

BEARINGS SHOWN HEREON ARE BASED ON THE CENTERLINE OF 162 ND STREET (FORMERLY MARKET STREET) BEING N 89° 55' 30" E SHOWN ON TRACT NO. 10901, M.B. 254/31-32

**BENCHMARK:** 

THE CITY OF GARDENA BENCHMARK NO. 5D-15 ELEV. = 43.508




Structural Engineers

23682 Birtcher Drive

Lake Forest, CA 92630 949 770-9967



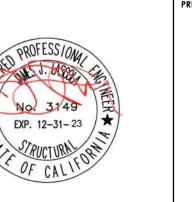





REVISIONS 90% CD SUBMITTAL 08/16/2023

DESIGNED BY


DRAWN BY


CITY OF GARDENA DEPARTMENT OF PUBLIC WORKS - ENGINEERING CONSTRUCTION DETAILS

**COMMUNITY AQUATICS & SENIOR CENTER** L-2.02

11/14/2022 TP 06/20/2023 CHECKED BY

SHT. 17 OF 176 DWG. NO. 5-2606

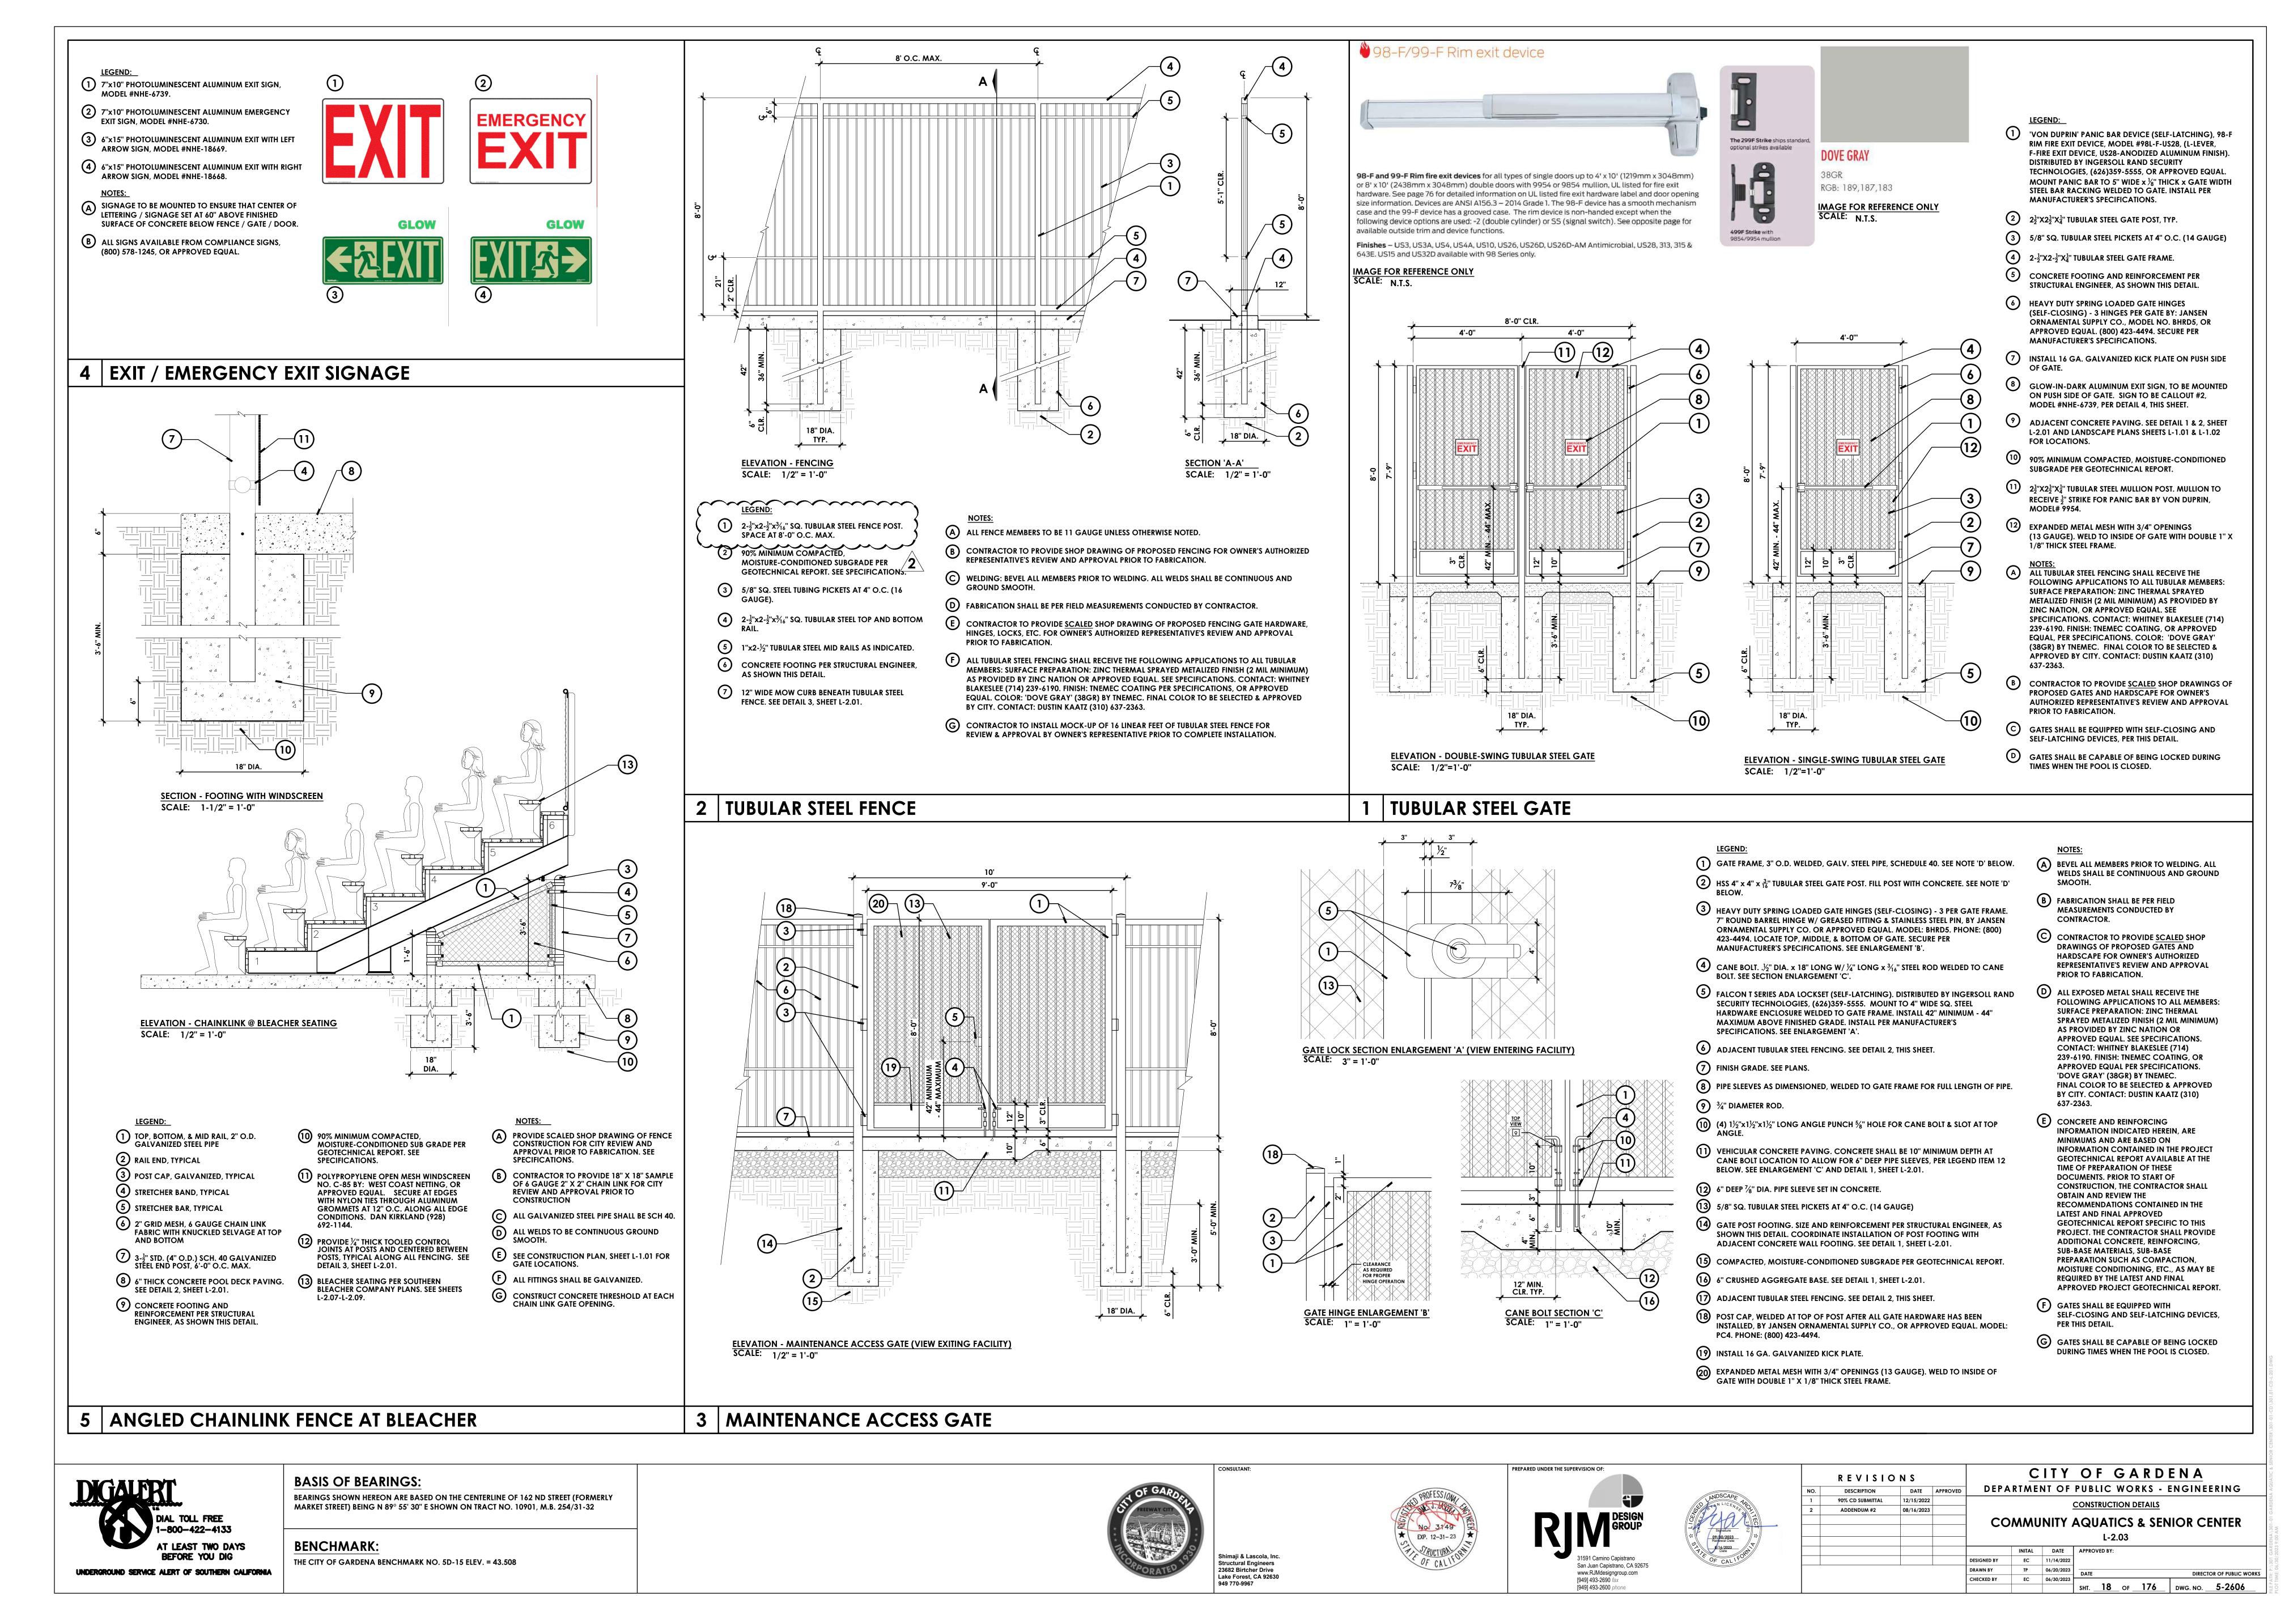

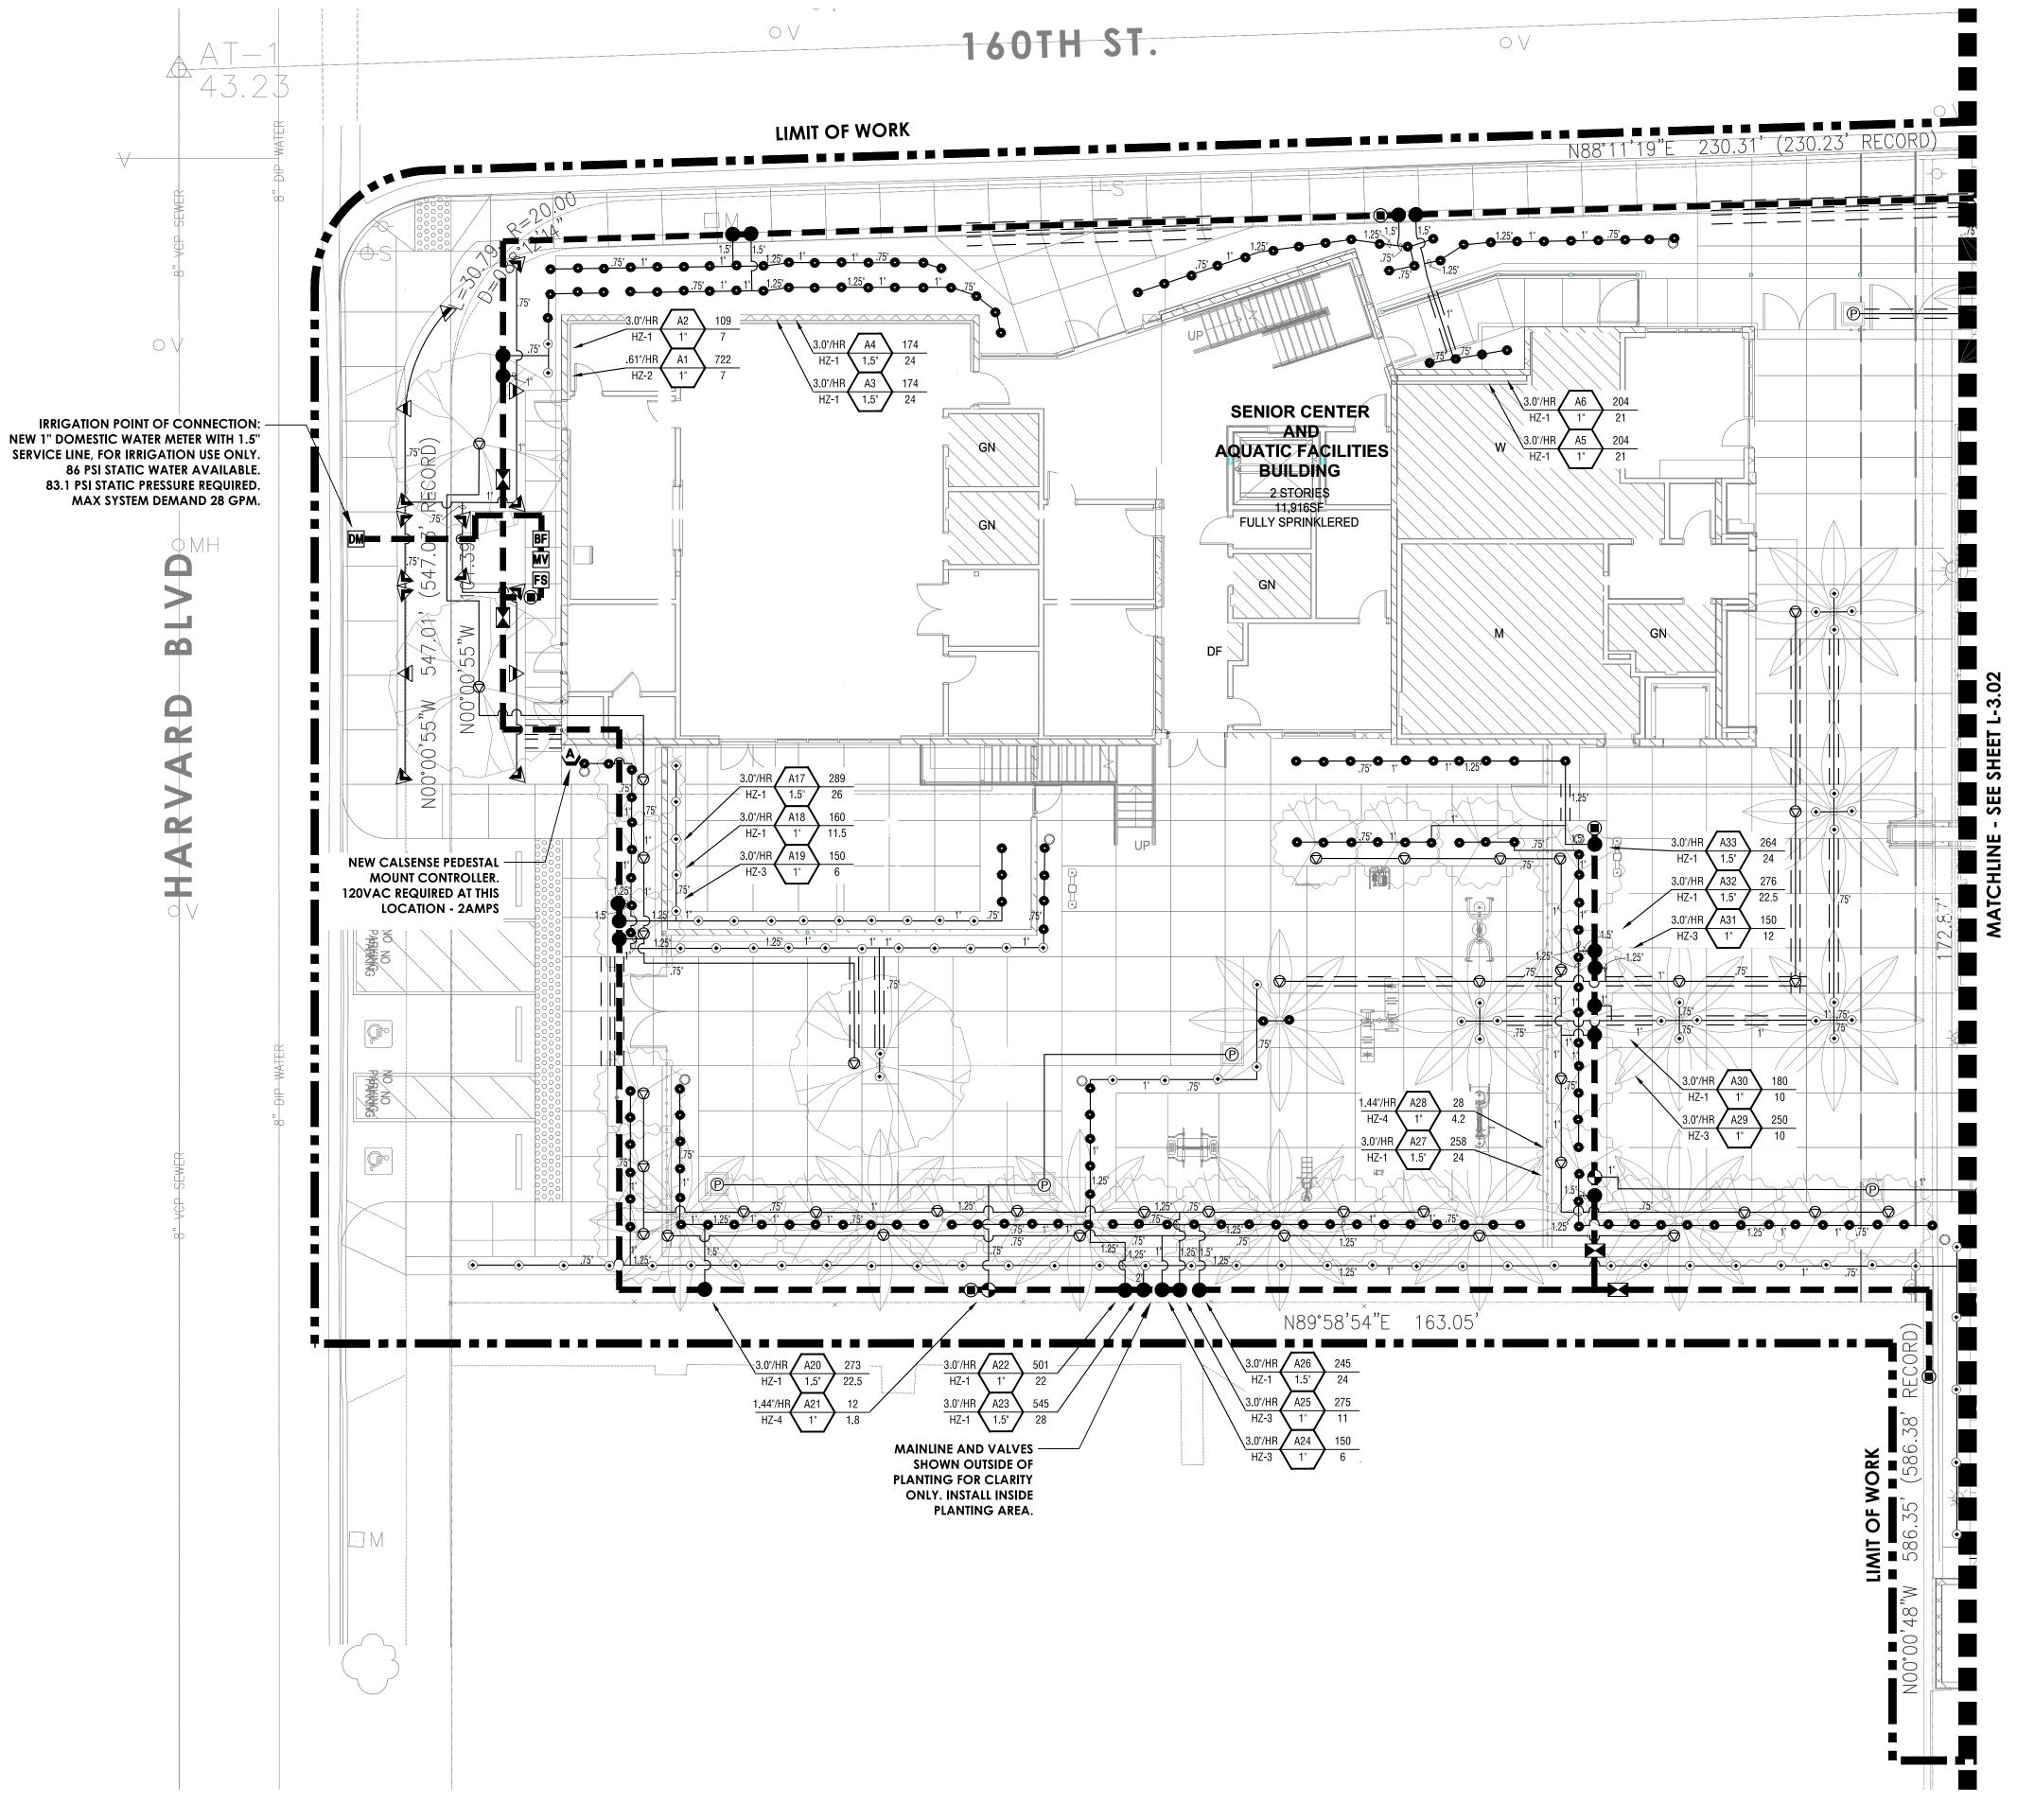

# **IRRIGATION NOTES**

NOTE A: MAINLINE AND RELATED EQUIPMENT SHOWN WITHIN PAVING FOR CLARITY ONLY, ACTUAL MAINLINE AND RELATED EQUIPMENT LOCATION TO BE WITHIN PLANTERS AND A MINIMUM OF 18" OFF ADJACENT HARDSCAPE AND OTHER OBSTACLES TYP.

BUBBLERS AND LATERAL LINES ARE SHOWN WITHIN PAVING FOR CLARITY ONLY, ACTUAL LOCATION TO BE WITHIN PLANTER. BUBBLERS SHALL BE ALIGNED WITH TREES AND AS DIRECTED BY OWNER'S AUTHORIZED REPRESENTATIVE. CONFIRM ALL LAYOUT IN FIELD WITH OWNER'S AUTHORIZED REPRESENTATIVE PRIOR TO STARTING WORK.

CONTRACTOR SHALL PROVIDE THE CITY WITH A NEATLY DRAWN LAMINATED IRRIGATION CONTROLLER CHART.

I HAVE COMPLIED WITH THE CRITERIA OF THE IRRIGATION GUIDELINES AND APPLIED THEM ACCORDINGLY FOR THE EFFICIENT USE OF WATER IN THE IRRIGATION DESIGN

**BENCHMARK:** 


REFER TO SHEETS L-4.01 FOR IRRIGATION DETAILS

			CIT	Y OF	GAF	RDENA (	COMM	UNITY	AQUA	TICS C	ENTER IF	RRIGA	ATION	RUN	TIMI	ES (II	N MIN	NUTE	S)				
			JAN	FEB	MAR	APR	MAY	JUNE	JULY	AUG	SEP	ОСТ	NOV	DEC			Turf Ro	ot Depth			4"		
CYCL	ES PER W	EEK - TURF	2	2	3	5	5	6	6	6	4	3	2	2			Shrub Ro	oot Dept	h		6"		
TURF	F CROP CC	EFFICIENT	.61	.64	.75	1.04	.95	.88	.94	.86	.74	.75	.69	.60		Depletion Factor (MAD)		Depletion Factor (MAD) 40%					
CYCLES PER	R WEEK-SI	IRUB/TREE	1	1	2	2	2	3	3	3	2	2	1	1									
																S	oil Type	(Textura	al)	CLAY	LOAM		
Eto DA	AILY AVER	AGE	.07	.09	.12	.16	.17	.20	.21	.20	.16	.12	.09	.07			Field Capacity						
																Pe	ermanen	Wilt Po	int		3%		
																Арр	arent Sp	ecific Gr	avity	1	.35		
												s.				IRRI	GATION	RUN TIN	IES				
Hydrozone	PLANT TYPE	Water Usage	Kc	100000000000000000000000000000000000000	KLER PE	EXPOSURE	EXPO FACTOR	PRECIP (in/hr)	SPKLR EFFIC.	ROOT DEPTH (in)	RUN TIME MULTIPLIER	JAN	FEB	MAR	APR	MAY	JUN	JUL	AUG	SEP	ост	NOV	DE
1	SHRUB	LOW	0.20	BUB	BLER	FULL SUN	100%	3.00	81%	6	1.23	2	3	2	3	3	2	2	2	3	2	3	2
2	TURF	VARIABLE	Var	RO	TARY	FULL SUN	100%	0.61	75%	12	1.33	20	26	28	31	30	27	30	26	27	28	29	19
3	TREE	MEDIUM	0.50	BUB	BLER	FULL SUN	100%	3.00	81%	12	1.23	6	8	5	7	7	6	6	6	7	5	8	6
4	POTS	MEDIUM	0.50	DF	RIP	FULL SUN	100%	1.44	75%	6	1.33	14	18	12	16	17	13	14	13	16	12	18	14

# IRRIGATION EQUIPMENT LEGEND

SYMBOL	MANUFACTURER	MODEL NO. / DESCRIPTION	G	SPM	PSI	RADIUS (FT.)	PRECIP.	DETAIL				
Q H F												
<b>♡</b>	RAIN BIRD	RD-06-S-P30-F/5Q-B POP-UP BUBBLER HEAD, EACH SYMBOL REPRESENTS TWO BUBBLERS PER BOX TREE. PLACE BUBBLERS OUTSIDE OF ROOTBALL ON OPPOSITE SIDES OF TREE. ADJUST PER ROOTBALL SIZE TYPICAL.	0	0.50 (1.0)	30	5	3.0 IN./HR	A,B				
$\blacktriangleright lacktriangleright$	RAIN BIRD	RD-06-S-P45-F - R-VAN14, 6" POP-UP WITH CHECK VALVE ,PRESSURE REGULATOR, AND ADJUSTABLE ROTARY NOZZLE. FULL NOZZLE SHALL BE R-VAN14-360	0	.32-1.27	45	8-14	0.61 IN./HR.	Α				
ightharpoons												
								A				
•	RAIN BIRD	RD-06-S-P30-F/5CST-B POP-UP STREAM BUBBLER HEAD - 2 STREAMS	0	.50	30	3	3.0 IN./HR	Α				
•	RAIN BIRD							A				
P	P RAIN BIRD XFCV-09-12-XX LANDSCAPE DRIP TUBING W/ .9 GPH EMITTERS 12" ON CENTER. DRIP TUBING HAS BUILT IN CHECK VALVES. DRIP TUBING SHALL BE INSTALLED AT GRADE UNDER MULCH, AND IN BINGS (1) RING PER 16" POT AND (2) RINGS PER 24" POT. ESTIMATE 40 LINEAR FEET OF DRIPLINE TUBING PER POT. INSTALL TUBING STAKES A MAXIMUM OF FIVE (5) FEET ON CENTER. INSTALL A DRIP INDICATOR IN THE (2) FURTHEST POTS ON OPPOSITE SIDES OF THE VALVE ZONE.						1.44 IN./HR.	C,D				
	NIBCO	T-113 GATE VALVE, LINE SIZE, WITH BRONZE WHEEL HANDLE UP TO 2" INSTALLED IN A RECTANGULAR BOX						E				
DM	WATER METER	EXISTING WATER METER FOR LANDSACPE ONLY REFER TO CIVIL PLANS FOR FINAL LOCATION.				/	<b>2</b> \	N/A				
BF	FEBCO/WATTS/ STRONG BOX	2" LF 825 YA LEAD FREE BACKFLOW PREVENTER WITH LF777-304SS#60 STRAINER AND V.I.T. STRONGBOX SBBC-22SS SMO	OOTH TOUCH STAINL	LESS STEEL ENCLOSU	RE ON QP-	22BF QUICK PAD.	)	F				
MV FS	SUPERIOR/ CALSENSE		ASTER VALVE AND FLOW SENSOR. 3100150PRS NORMALLY OPEN 1.5" BRASS MASTER VALVE WITH PRESSURE REGULATOR AND CALSENSE FM-125B 5" BRASS FLOW SENSOR. INSTALL BOTH PER MANUFACTURER'S RECOMMENDATIONS AND WIRE DIRECTLY TO THE CONTROLLER.									
A	CALSENSE  CS3-48-S/FM-125B/CS3-GR-BUNDLE-2/3100150PRS CONTROLLER. CONTACT JEFF DRONGOWSKI WITH CALSENSE FOR ORDERING (760) 580-9428.  CS3000 SERIES 48 STATION CONTROLLER IN A STAINLESS STEEL TOP ENTRY ENCLOSURE W/ CELL CARD, ANTENNA. CONTRACTOR SHALL CONTACT CALSENSE TO INSURE PROPER COMMUNICATION WITH THE CITY'S CENTRAL CONTROL SYSTEM. CONTROLLER WILL COMMUNICATE WITH THE CITY'S CENTRAL CONTROL SYSTEM.							L				
	RAIN BIRD	44LRC 1" QUICK COUPLER VALVE WITH LOCKING COVER, INSTALL WITHIN 10" ROUND VALVE BOX						1				
•	RAIN BIRD	1X0-EFB-CP-PRS-D, BRASS REMOTE CONTROL VALVE W/ PRESSURE REGULATOR, SEE PLAN FOR SIZE.						J				
•	RAIN BIRD	XCZ-PRB-100-COM (1",1 1/2") DRIP VALVE CONTROL ZONE ASSEMBLY, SIZE AS SHOWN						K				
	AS APPROVED	PVC PIPE 3/4" - 2" SCH. 40 WITH SCH.40 FITTINGS AS LATERAL LINES 12" BELOW GRADE, AND ABOVE THE FIELD SUB DRAIN	NS.					М				
	AS APPROVED	PVC PIPE 2" CL. 315 SOLVENT WELD WITH SCH.80 FITTINGS AS MAINLINES-24" DEPTH						М				
	AS APPROVED	PVC PIPE SCH. 40 AS SLEEVING, 2 TIMES THE DIAMETER OF PIPE OR WIRE BUNDLE CARRIED. PLACE BELOW ALL PAVING, HARDSCAPE ETC. AND AS DIRECTED BY OWNER'S AUTHORIZED REPRESENTATIVE.						N				
NO SYMBOL	AS APPROVED	DIRECT BURIAL WATER-PROOF WIRE CONNECTORS FOR USE ON ALL WIRE CONNECTIONS (U.L. APPROVED).						N/A				
NO SYMBOL	NDS	PRO SERIES/PRO SERIES PLUS VALVE BOXES, SIZE PER EQUIPMENT DETAILS, LEGEND, AND SPECIFICATIONS.  10" ROUND SHALL BE MODEL 311BCBLK, 14" X 19" STANDARD RECT. SHALL BE MODEL 313BCBBLK 2  VALVE BOXES SHALL HAVE BLACK BODY AND BLACK LIDS.  FOR USE IN NON-VEHICULAR TRAFFIC SITUATIONS ONLY. DO NOT INSTALL IN CONCRETE OR ASPHALT.						N/A				
		CONTROL VALVE SYMBOL H	HYDROZONE	HYDROZONE D	ESCRIPTIO	ON						
		INDICATES VALVE NO.		LOW WATER SH								
		PRECIP No. A INDICATES SQUARE FOOT AREA	2	HIGH WATER TU	RF WITH F	ROTARYS						
		HZ Size GPM INDICATES GPAA	3	MED WATER TRE	FS WITH I	RIIRRIFPS						

HZ Size GPM INDICATES GPM INDICATES VALVE SIZE

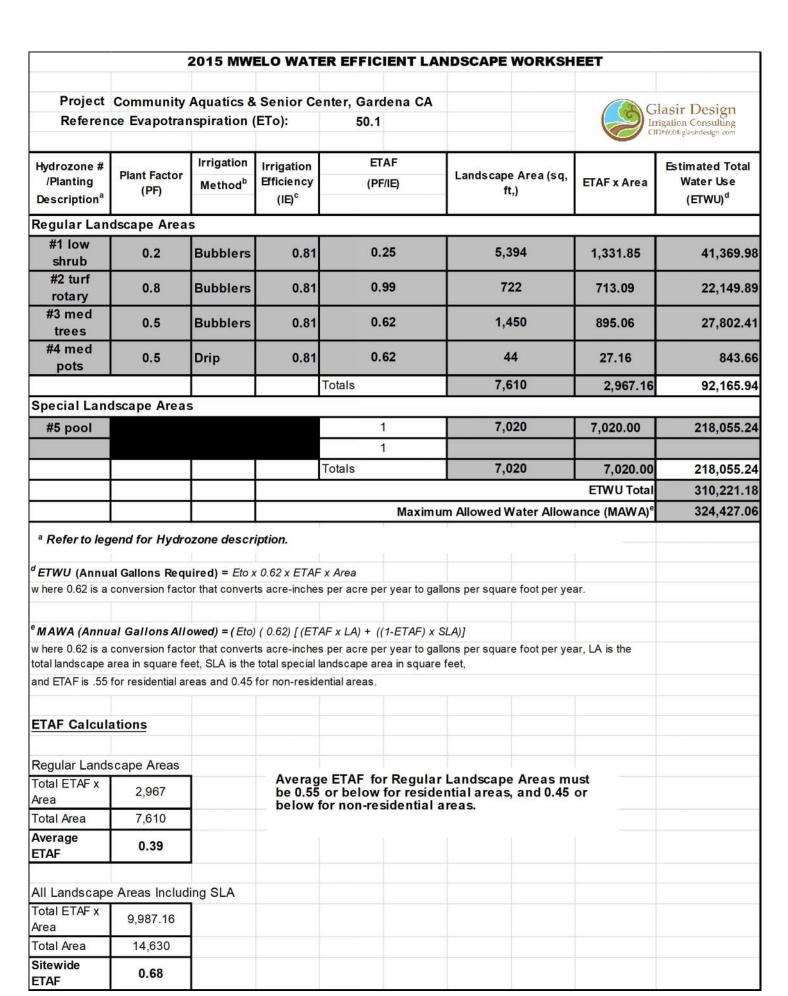

IRR	RIGATION WA	TER P	RESSURE	LOSS (	CALCUL	ATION	S	
WATER METER	NUMBER	IRR	WATER METE	R SIZE	1	INCHES		
WATER METER	ELEVATION (FT)		HIGHEST HEA	D ELEVAT	ION		FT	
REMOTE CONT	ROL VALVE #	A1	STATIC WATE	R PRESSU	RE	86	PSI	
RCV DEMAND	(GPM)	7	TOTAL DEMA	ND		28	GPM	
SIZE (INCHES)	DESCRIPTION				GPM	PRESSURI	LOSS	
1.0	SERVICE LINE				28	4.75	PSI	
1.0	WATER METER (DIS	C TYPE)			28	4.6	PSI	
2.0	BACKFLOW PREVEN	13.0	PSI					
2.0	BACKFLOW ASSEME	0.6	PSI					
2.0	2.0 FILTERATION 28							
2.0	PRESSURE REGULAT	4.0	PSI					
1.5	MASTER VALVE	7	1	PSI				
2.0	ISOLATION VALVE				7	1.0	PSI	
2.0	PVC CL 315 MAINLII	NE (FT)		50	7	0.4	PSI	
1.5	REMOTE CONTROL	VALVE A	ASSEMBLY		7	0.7	PSI	
N/A	LATERAL LINE LOSS	ES			7	4.5	PSI	
N/A	FITTING LOSSES				7	1.3	PSI	
TOTAL PRESSU	RE LOSS OF ALL COM	1PONEN	TS			38.1	PSI	
PRESSURE REQ	UIRED AT HEAD (OP	ERATING	G PRESSURE)			45.0	PSI	
	11 · D ·		ELEVATION L	OSS (FT)	0	0.0	PSI	
(8)	Glasir Desig	n	TOTAL PRESS	URE REQU	JIRED	83.1	PSI	
Irrigation Consulting CID#6004-glasirdesign.com							PSI	
	112# 0004-grash design.c	omi	RESIDUAL WA	ATER PRES	SURE	2.9	PSI	
SET PRESSURE	REGULATOR OR MAS	STER CC	NTROL VALVE	AT		N/A	PSI	
PRESSURE BOOST, IF REQUIRED (SET TO ACHIEVE 100 KPA RESIDUAL)  N/A PSI								

3 MED WATER TREES WITH BUBBLERS 4 MED WATER POTS WITH DRIPLINE



**BASIS OF BEARINGS:** BEARINGS SHOWN HEREON ARE BASED ON THE CENTERLINE OF 162 ND STREET (FORMERLY MARKET STREET) BEING N 89° 55' 30" E SHOWN ON TRACT NO. 10901, M.B. 254/31-32












	REVISIO	N S		CITY OF GARDENA
I	DESCRIPTION	DATE	APPROVED	DEPARTMENT OF PUBLIC WORKS - ENGINEERING
	90% CD SUBMITTAL	12/15/2022		IRRIGATION PLAN
	ADDENDUM #2	08/16/2023		IRRIGATION LAN
				COMMUNITY AQUATICS & SENIOR CENTER
T				COMMONT AQUATICO & SENTON CENTER

IRRIGATION PLAN AQUATICS & SENIOR CENTER

INITAL DATE APPROVED BY: EC 11/14/2022 DESIGNED BY

TP 06/20/2023 DATE

EC 06/30/2023 DIRECTOR OF PUBLIC WORKS sht. <u>33</u> of <u>176</u> dwg. no. <u>5-2606</u>

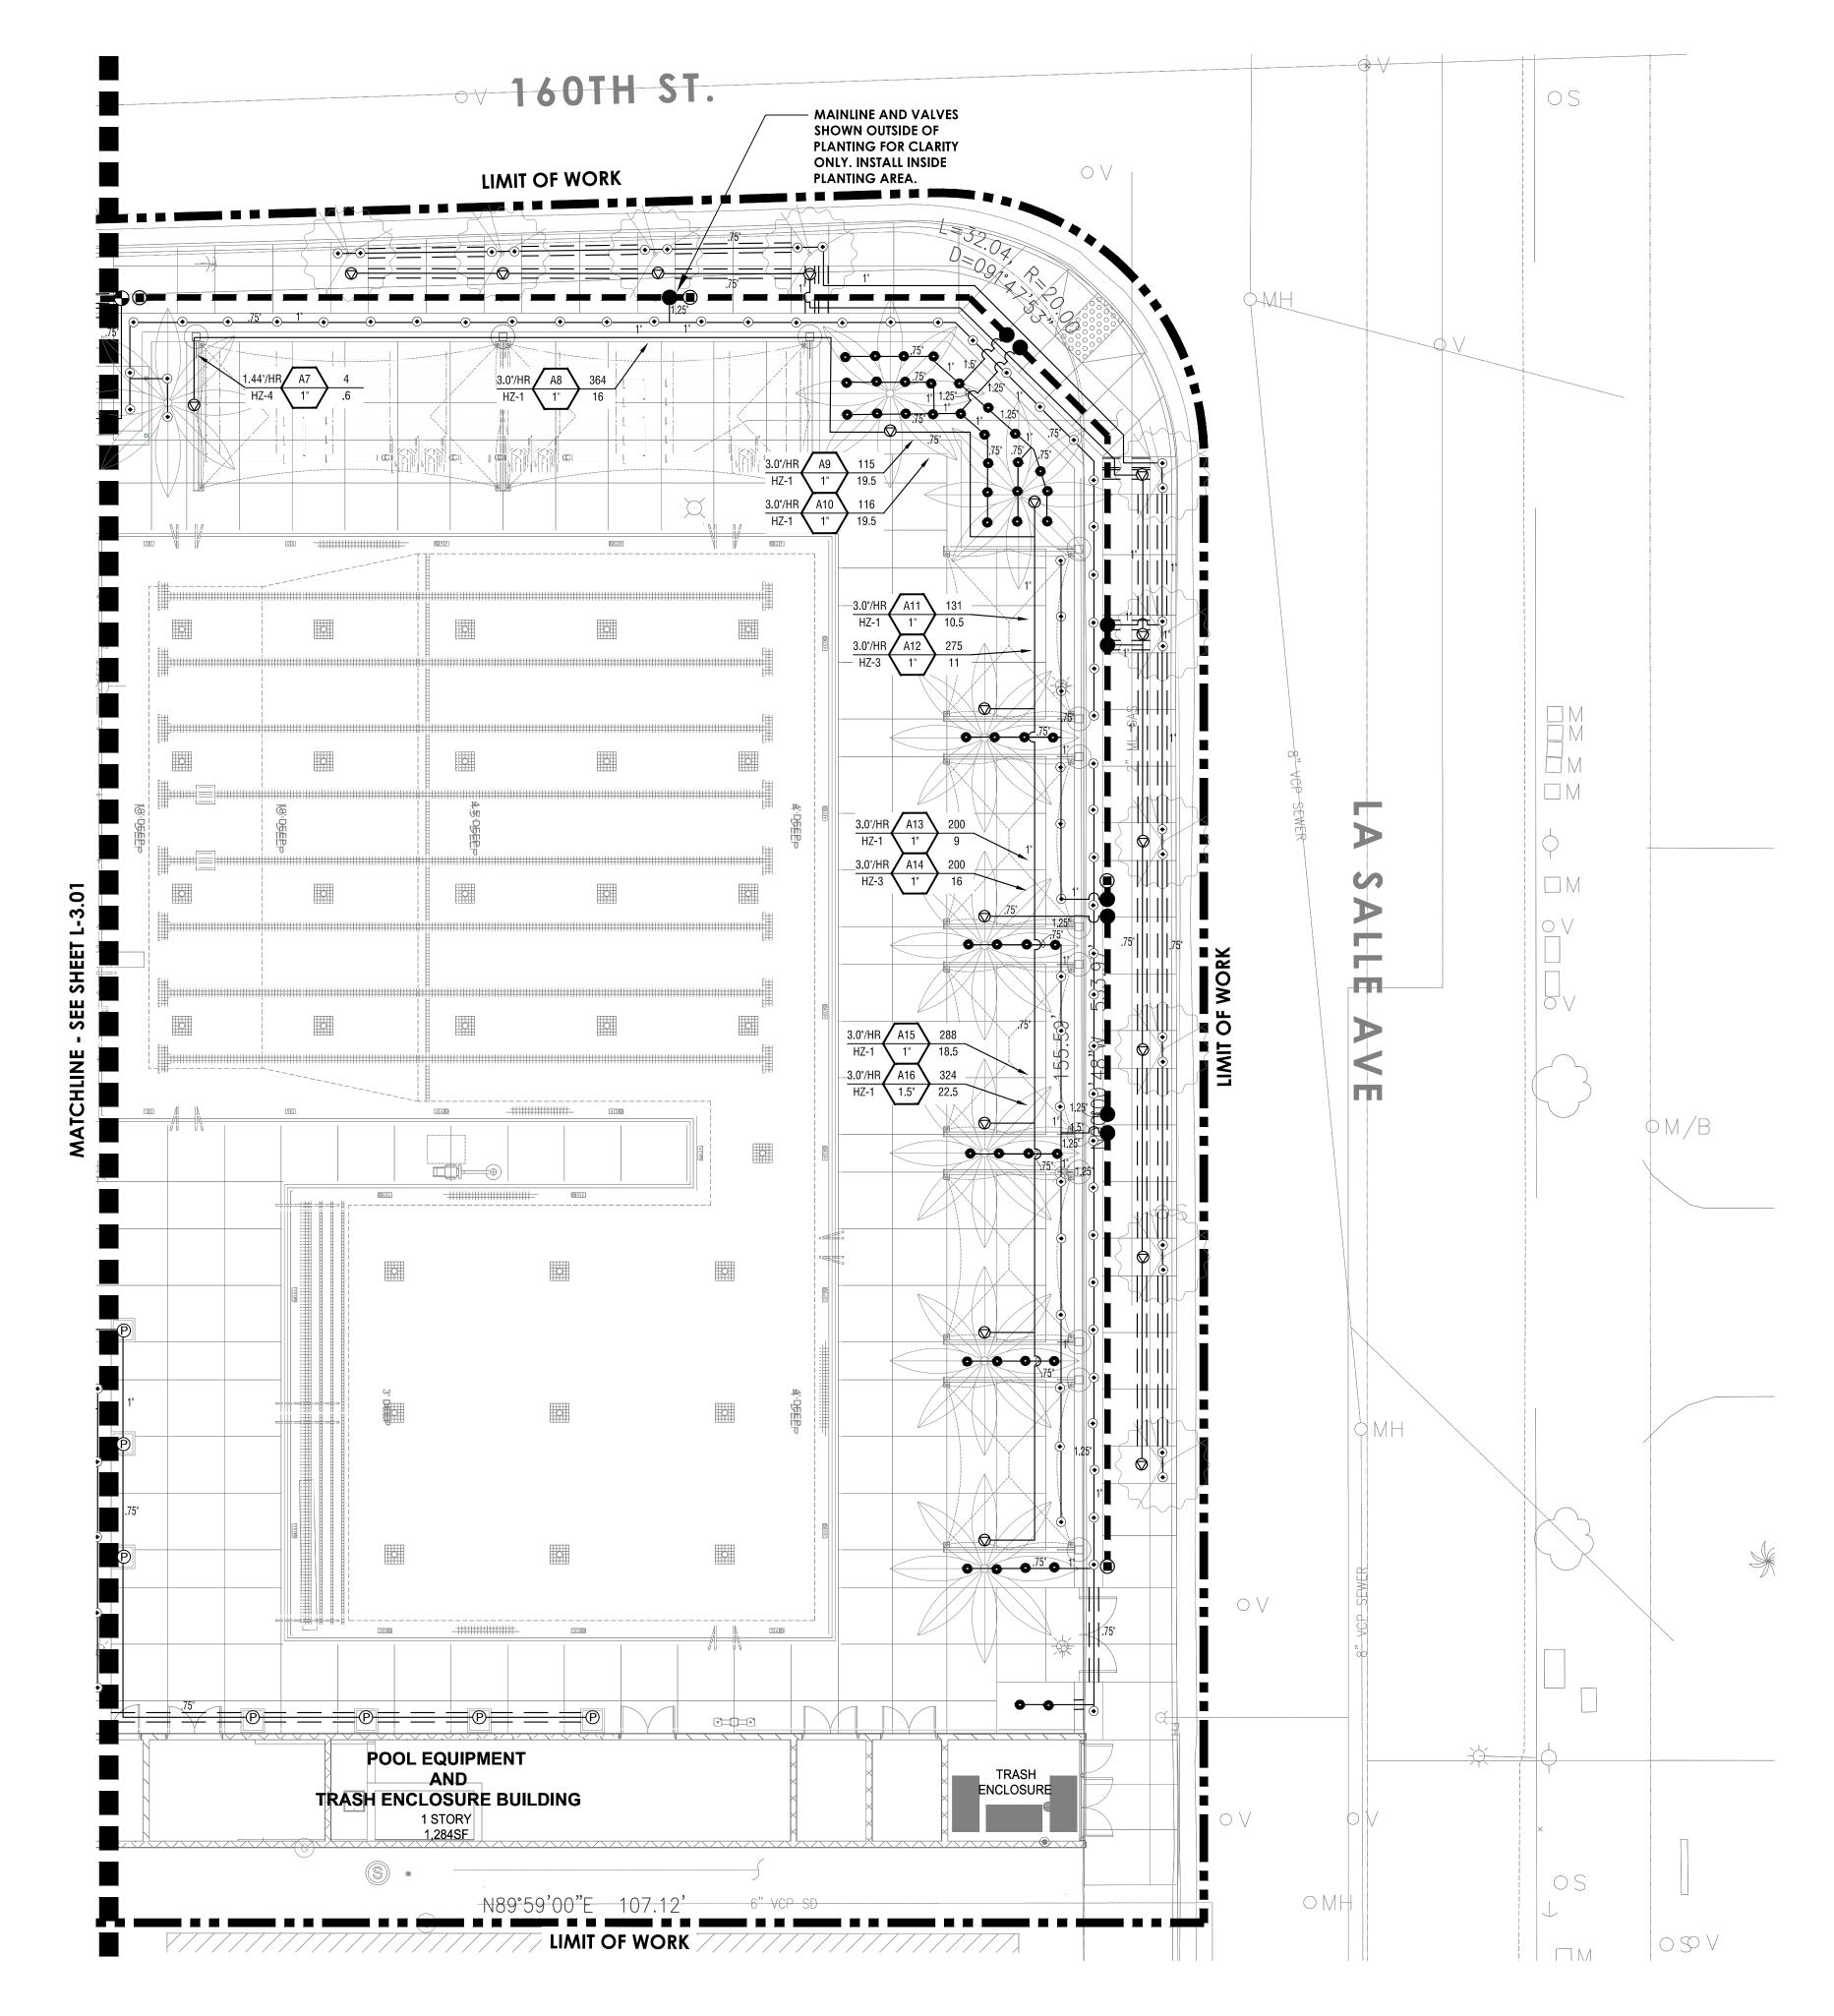

# IRRIGATION NOTES

MAINLINE AND RELATED EQUIPMENT SHOWN WITHIN PAVING FOR CLARITY ONLY, ACTUAL MAINLINE AND RELATED EQUIPMENT LOCATION TO BE WITHIN PLANTERS AND A MINIMUM OF 18" OFF ADJACENT HARDSCAPE AND OTHER OBSTACLES TYP.


BUBBLERS AND LATERAL LINES ARE SHOWN WITHIN PAVING FOR CLARITY ONLY, ACTUAL LOCATION TO BE WITHIN PLANTER. BUBBLERS SHALL BE ALIGNED WITH TREES AND AS DIRECTED BY OWNER'S AUTHORIZED REPRESENTATIVE. CONFIRM ALL LAYOUT IN FIELD WITH OWNER'S AUTHORIZED REPRESENTATIVE PRIOR TO STARTING WORK.

CONTRACTOR SHALL PROVIDE THE CITY WITH A NEATLY DRAWN LAMINATED IRRIGATION CONTROLLER CHART.

I HAVE COMPLIED WITH THE CRITERIA OF THE IRRIGATION GUIDELINES AND APPLIED THEM ACCORDINGLY FOR THE EFFICIENT USE OF WATER IN THE IRRIGATION DESIGN

REFER TO SHEETS L-4.01 FOR IRRIGATION DETAILS



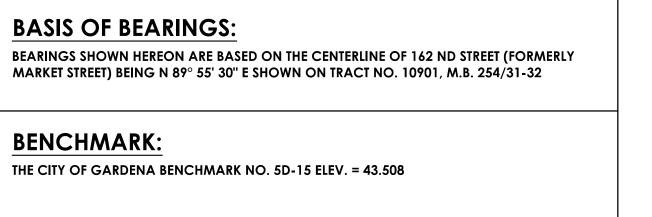







PREPARED UNDER THE SUPERVISION OF:



ANDSCAPE	
ANDSCAPE VACENOCIAL STREET	
Signature Signature	
09/30/2023 // 🌣 //	
8/16/2023 Date Date	
8/16/2023 Date OF CAL 1FORT	

	REVISIO
NO.	DESCRIPTION
1	90% CD SUBMITTAL
2	ADDENDUM #2

12/15/2022

08/16/2023

IRRIGATION EQUIPMENT LEGEND

RD-06-S-P30-F/5Q-B POP-UP BUBBLER HEAD, EACH SYMBOL REPRESENTS TWO

SIDES OF TREE. ADJUST PER ROOTBALL SIZE TYPICAL.

BUBBLERS PER BOX TREE. PLACE BUBBLERS OUTSIDE OF ROOTBALL ON OPPOSITE

RD-06-S-P45-F - R-VAN14, 6" POP-UP WITH CHECK VALVE , PRESSURE REGULATOR,

RD-06-S-P45-F - R-VAN18. 6" POP-UP WITH CHECK VALVE .PRESSURE REGULATOR.

NOTE: CONTRACTOR SHALL USE SQ-F NOZZLE IN THE EVENT ANY SHRUBS DO NOT RECIEVE PROPER COVERAGE.

T-113 GATE VALVE, LINE SIZE, WITH BRONZE WHEEL HANDLE UP TO 2" INSTALLED IN A RECTANGULAR BOX

EXISTING WATER METER FOR LANDSACPE ONLY REFER TO CIVIL PLANS FOR FINAL LOCATION.

44LRC 1" QUICK COUPLER VALVE WITH LOCKING COVER, INSTALL WITHIN 10" ROUND VALVE BOX

1X0-EFB-CP-PRS-D, BRASS REMOTE CONTROL VALVE W/ PRESSURE REGULATOR, SEE PLAN FOR SIZE.

XCZ-PRB-100-COM (1",1 1/2") DRIP VALVE CONTROL ZONE ASSEMBLY, SIZE AS SHOWN

PVC PIPE SCH. 40 AS SLEEVING, 2 TIMES THE DIAMETER OF PIPE OR WIRE BUNDLE CARRIED.

PLACE BELOW ALL PAVING, HARDSCAPE ETC. AND AS DIRECTED BY OWNER'S AUTHORIZED REPRESENTATIVE.

DIRECT BURIAL WATER-PROOF WIRE CONNECTORS FOR USE ON ALL WIRE CONNECTIONS (U.L. APPROVED).

PRO SERIES/PRO SERIES PLUS VALVE BOXES, SIZE PER EQUIPMENT DETAILS, LEGEND, AND SPECIFICATIONS.

10" ROUND SHALL BE MODEL 311BCBLK, 14" X 19" STANDARD RECT. SHALL BE MODEL 313BCBBLK, 2

VALVE BOXES SHALL HAVE BLACK BODY AND BLACK LIDS.

CONTROL VALVE SYMBOL

HZ Size GPM INDICATES GPM INDICATES VALVE SIZE

PRECIP No. A INDICATES SQUARE FOOT AREA

—INDICATES VALVE NO.

FOR USE IN NON-VEHICULAR TRAFFIC SITUATIONS ONLY. DO NOT INSTALL IN CONCRETE OR ASPHALT.

PVC PIPE 2" CL. 315 SOLVENT WELD WITH SCH.80 FITTINGS AS MAINLINES-24" DEPTH

INSTALLED AT GRADE UNDER MUICH, AND IN PINGS (1) RING PER 16" POT.

AND (2) RINGS PER 24" POT. ESTIMATE 40 LINEAR FEET OF DRIPLINE TUBING PER POT. INSTALL TUBING STAKES A MAXIMUM OF FIVE
(5) FEET ON CENTER. INSTALL A DRIP INDICATOR IN THE (2) FURTHEST POTS ON OPPOSITE SIDES OF THE VALVE ZONE.

1.25" BRASS FLOW SENSOR. INSTALL BOTH PER MANUFACTURER'S RECOMMENDATIONS AND WIRE DIRECTLY TO THE CONTROLLER.

PVC PIPE 3/4" - 2" SCH. 40 WITH SCH.40 FITTINGS AS LATERAL LINES 12" BELOW GRADE, AND ABOVE THE FIELD SUB DRAINS.

MASTER VALVE AND FLOW SENSOR. 3100150PRS NORMALLY OPEN 1.5" BRASS MASTER VALVE WITH PRESSURE REGULATOR AND CALSENSE FM-125B

CS3-48-S/FM-125B/CS3-GR-BUNDLE-2/3100150PRS CONTROLLER. CONTACT JEFF DRONGOWSKI WITH CALSENSE FOR ORDERING (760) 580-9428. C\$3000 SERIES 48 STATION CONTROLLER IN A STAINLESS STEEL TOP ENTRY ENCLOSURE W/ CELL CARD, ANTENNA. CONTRACTOR SHALL CONTACT CALSENSE TO INSURE PROPER COMMUNICATION WITH THE CITY'S CENTRAL CONTROL SYSTEM. CONTROLLER WILL COMMUNICATE WITH THE CITY'S

AND ADJUSTABLE ROTARY NOZZLE. FULL NOZZLE SHALL BE R-VAN14-360

AND ADJUSTABLE ROTARY NOZZLE. FULL NOZZLE SHALL BE R-VAN18-360 RD-06-S-P45-F - R-VAN24, 6" POP-UP WITH CHECK VALVE, PRESSURE REGULATOR,

AND ADJUSTABLE ROTARY NOZZLE. FULL NOZZLE SHALL BE R-VAN24-360

RD-06-S-P30-F/5CST-B POP-UP STREAM BUBBLER HEAD - 2 STREAMS

RD-06-S-P30-F/5F-B POP-UP STREAM BUBBLER HEAD - 6 STREAMS.

CENTRAL CONTROL RAIN SENSING LOCATED OFF-SITE.

XFCV-09-12-XX LANDSCAPE DRIP TUBING W/ .9 GPH EMITTERS 12" ON

CENTER. DRIP TUBING HAS BUILT IN CHECK VALVES. DRIP TUBING SHALL BE

MANUFACTURER MODEL NO. / DESCRIPTION

Q H F

igorplus

\_\_\_\_\_

AS APPROVED

NO SYMBOL AS APPROVED

NO SYMBOL NDS

RAIN BIRD

RAIN BIRD

## CITY OF GARDENA DEPARTMENT OF PUBLIC WORKS - ENGINEERING DATE APPROVED

INITAL DATE APPROVED BY:

PSI RADIUS (FT.) PRECIP. DETAIL

.60 (TOTALS VARY) 30 N/A

HYDROZONE HYDROZONE DESCRIPTION

2 HIGH WATER TURF WITH ROTARYS

3 MED WATER TREES WITH BUBBLERS 4 MED WATER POTS WITH DRIPLINE

LOW WATER SHRUBS WITH BUBBLERS

~~~~~<u>{2\</u>

2" LF 825 YA LEAD FREE BACKFLOW PREVENTER WITH F777-304SS#60 STRAINER AND V.I.T. STRONGBOX SBBC-22SS SMOOTH TOUCH STAINLESS STEEL ENCLOSURE ON QP-22BF QUICK PAD.

3.0 IN./HR A,B

0.61 IN./HR. A

0.61 IN./HR. A

0.61 IN./HR. A

3.0 IN./HR A


3.0 IN./HR A

1.44 IN./HR. C,D

**COMMUNITY AQUATICS & SENIOR CENTER** 

DESIGNED BY EC 11/14/2022 
 DRAWN BY
 TP
 06/20/2023

 CHECKED BY
 EC
 06/30/2023
 DIRECTOR OF PUBLIC WORKS sht. **34** of **176** dwg. no. **5-2606** 

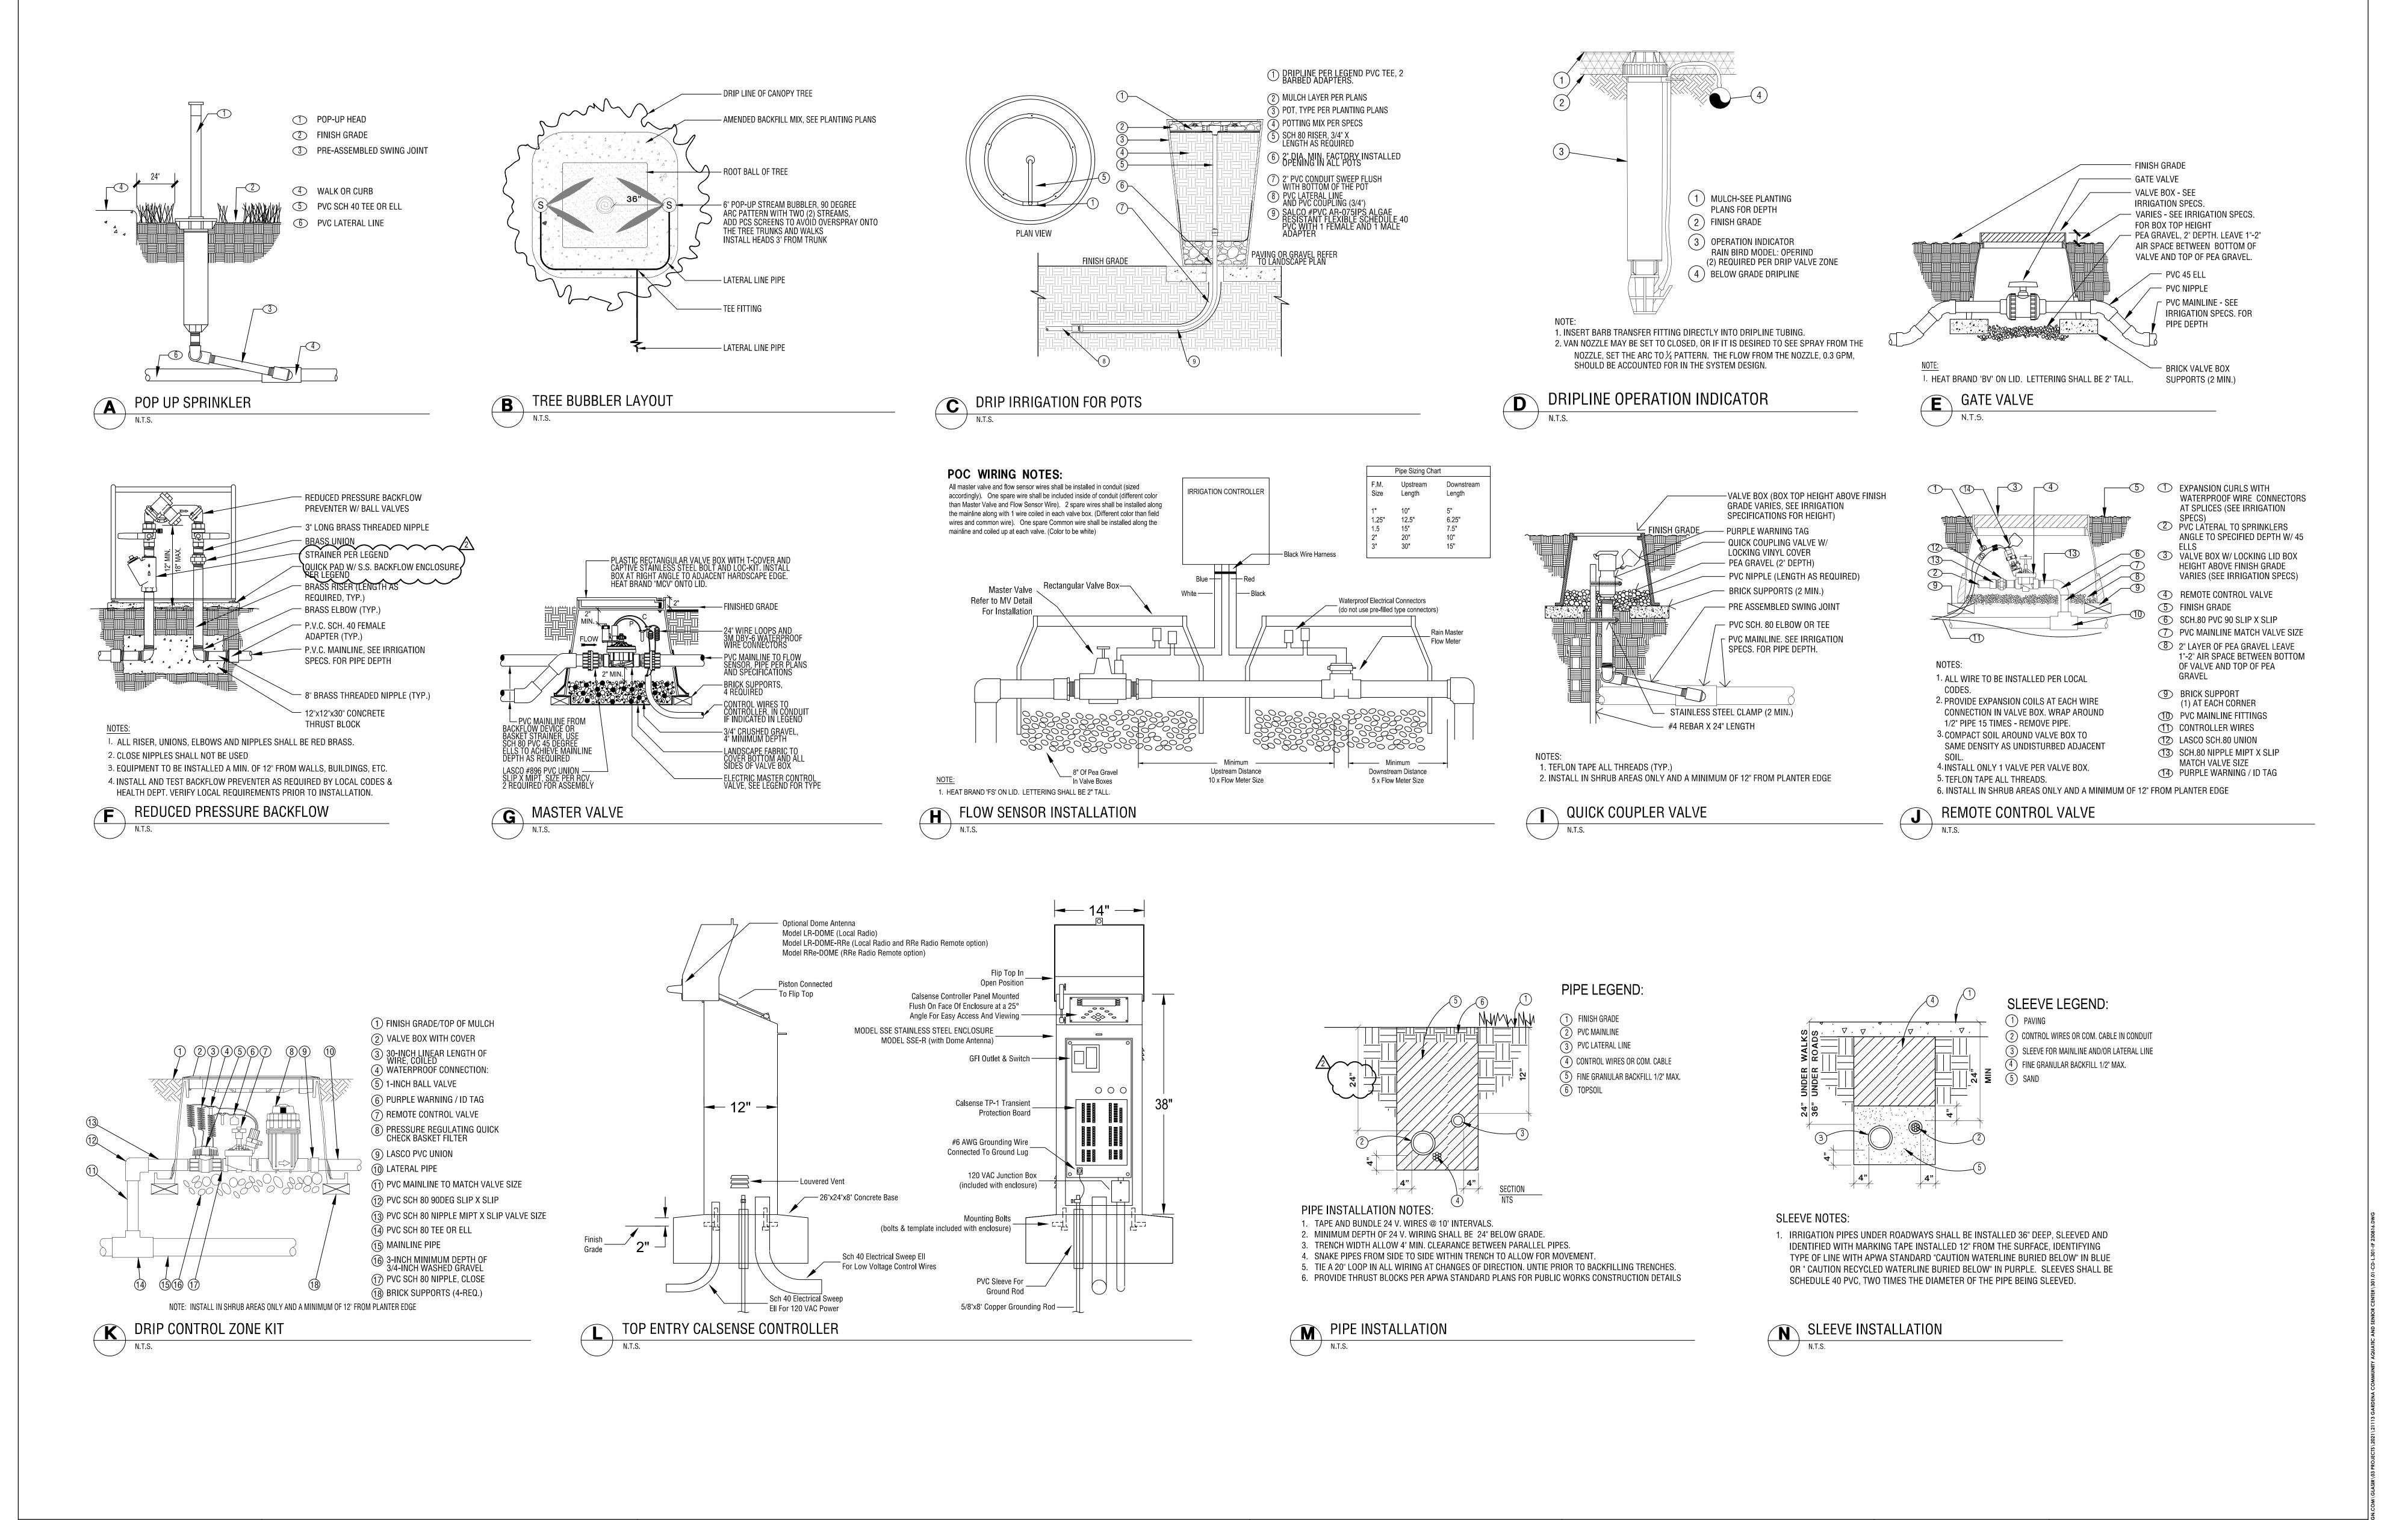

LEAST TWO DAYS BEFORE YOU DIG UNDERGROUND SERVICE ALERT OF SOUTHERN CALIFORNIA

BENCHMARK: THE CITY OF GARDENA BENCHMARK NO. 5D-15 ELEV. = 43.508

BEARINGS SHOWN HEREON ARE BASED ON THE CENTERLINE OF 162 ND STREET (FORMERLY

MARKET STREET) BEING N 89° 55' 30" E SHOWN ON TRACT NO. 10901, M.B. 254/31-32

**BASIS OF BEARINGS:** 









CITY OF GARDENA REVISIONS DEPARTMENT OF PUBLIC WORKS - ENGINEERING DESCRIPTION 90% CD SUBMITTAL 12/15/2022 ADDENDUM #2 08/16/2023

**COMMUNITY AQUATICS & SENIOR CENTER** 


INITAL DATE APPROVED BY: EC 11/14/2022 TP 06/20/2023 DIRECTOR OF PUBLIC WORKS EC 06/30/2023

SHT. <u>35</u> OF <u>176</u> DWG. NO. <u>5-2606</u>

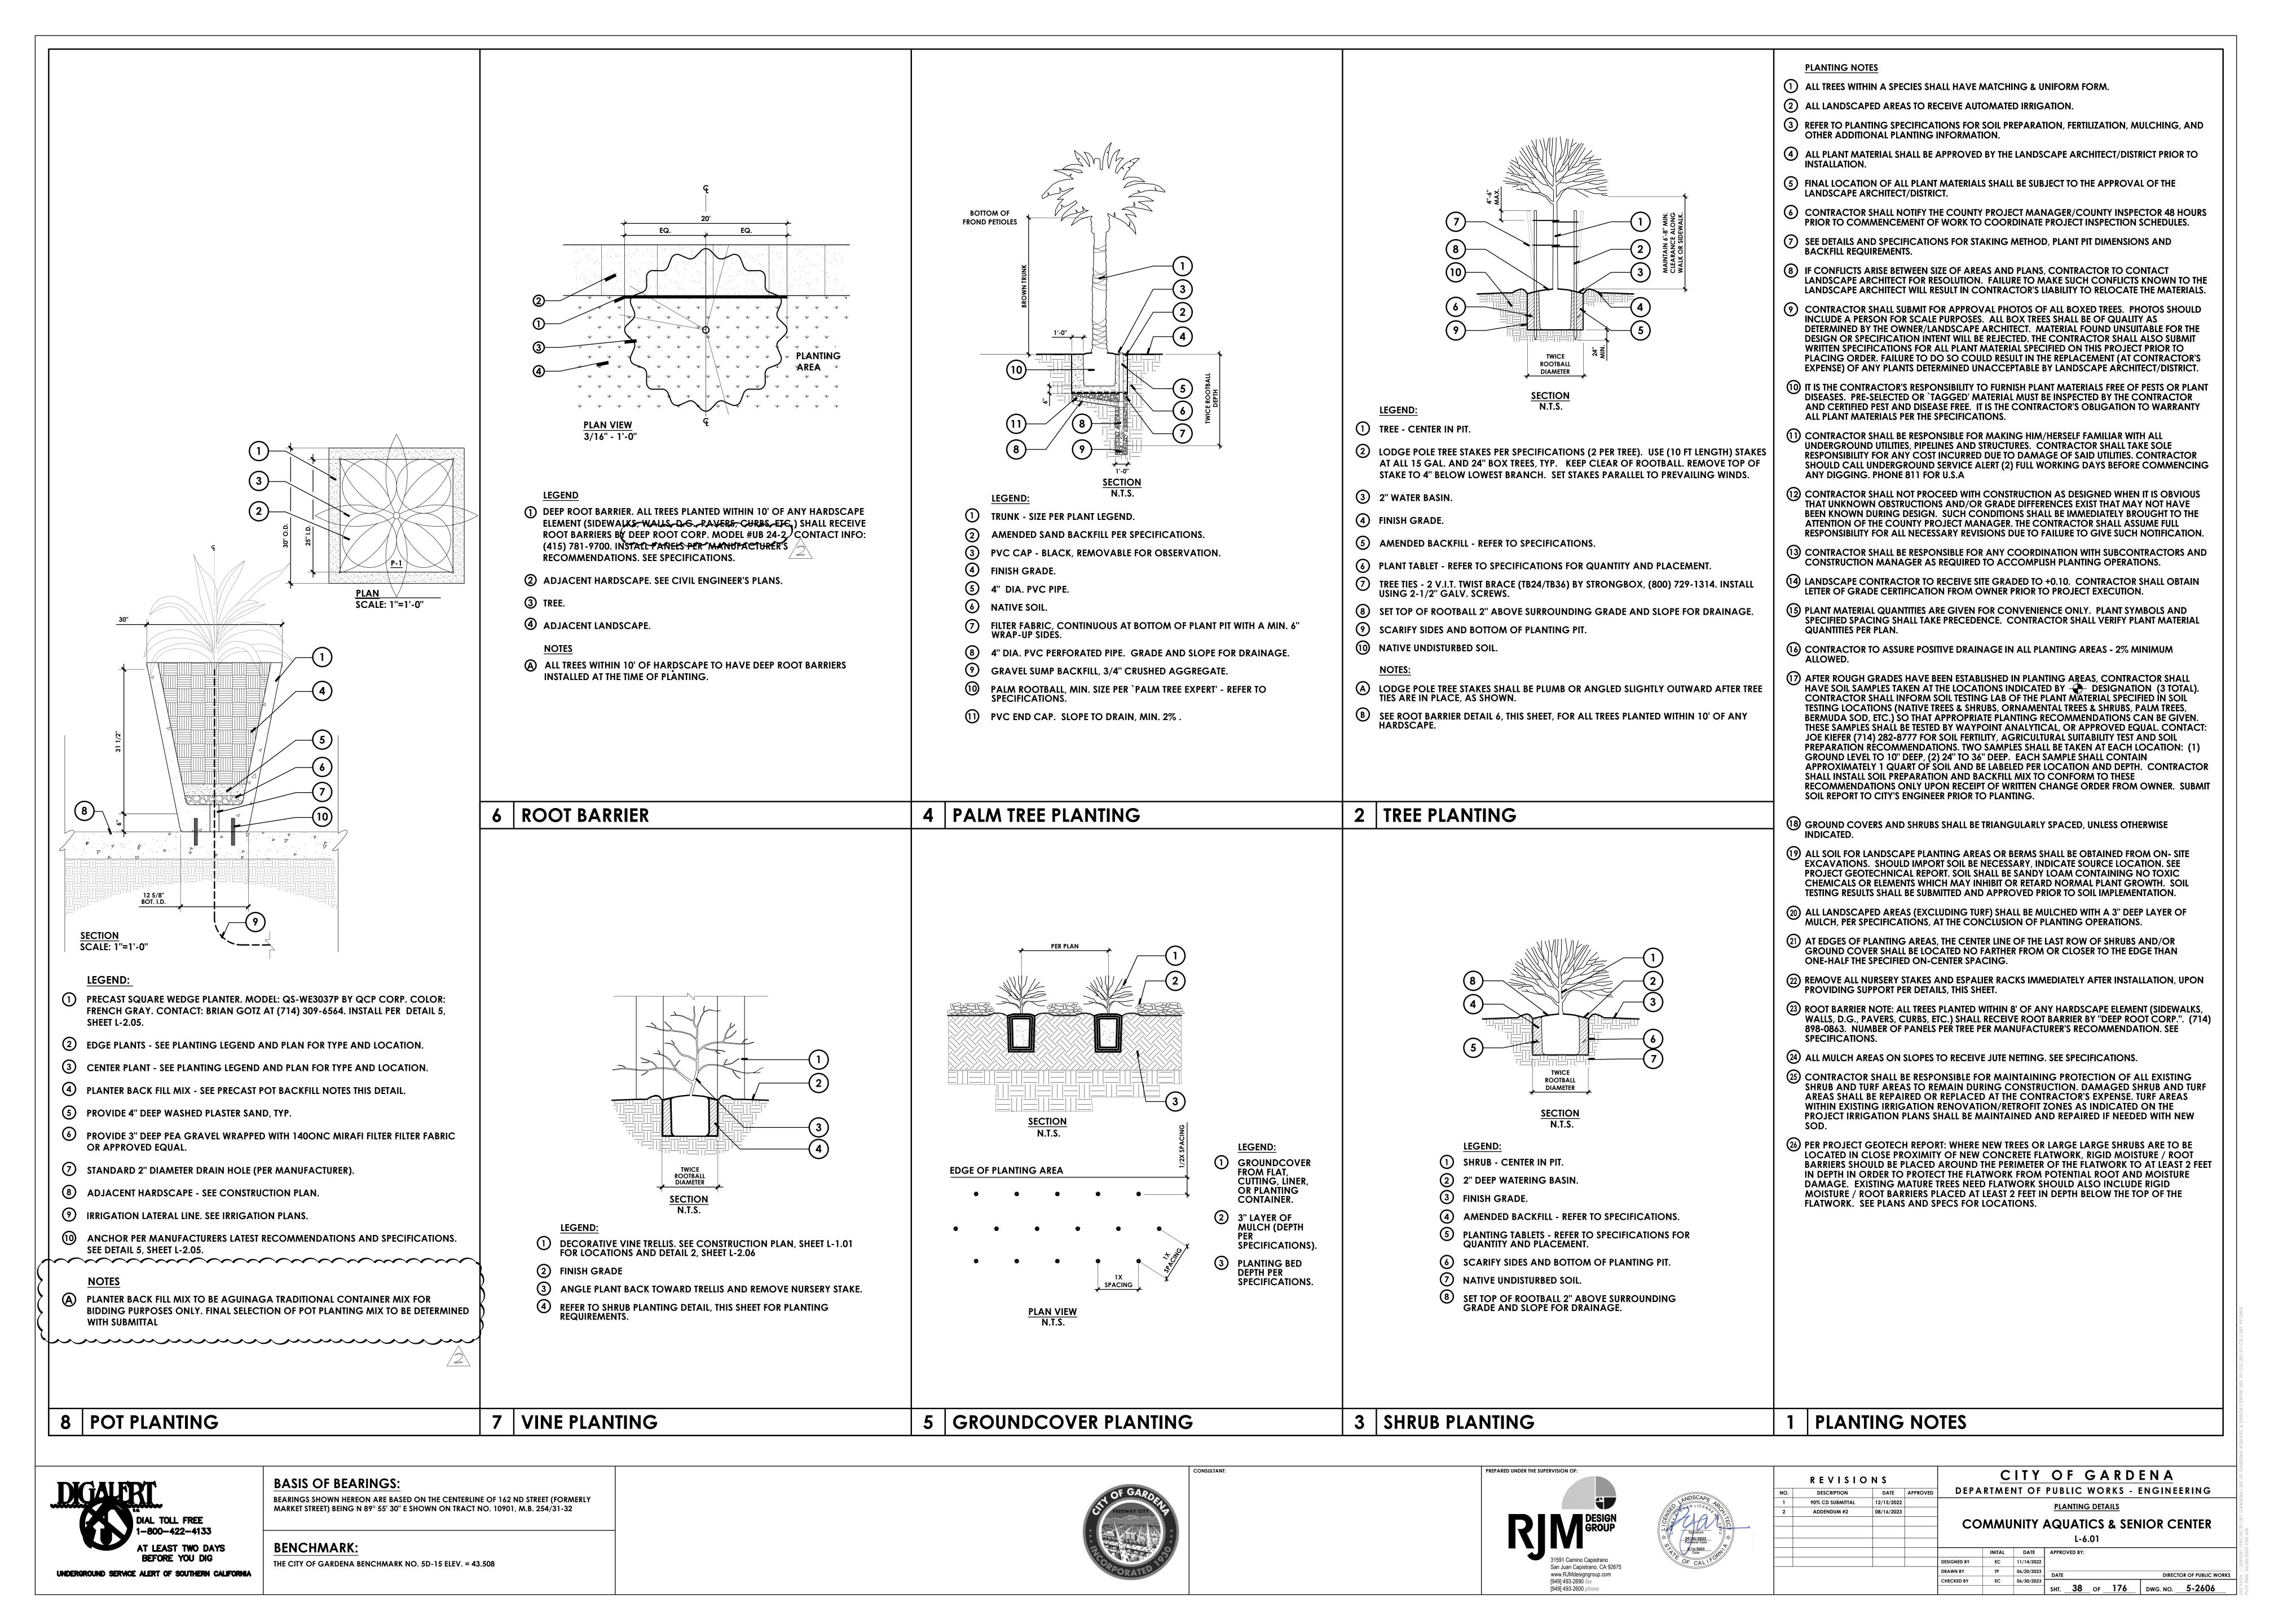

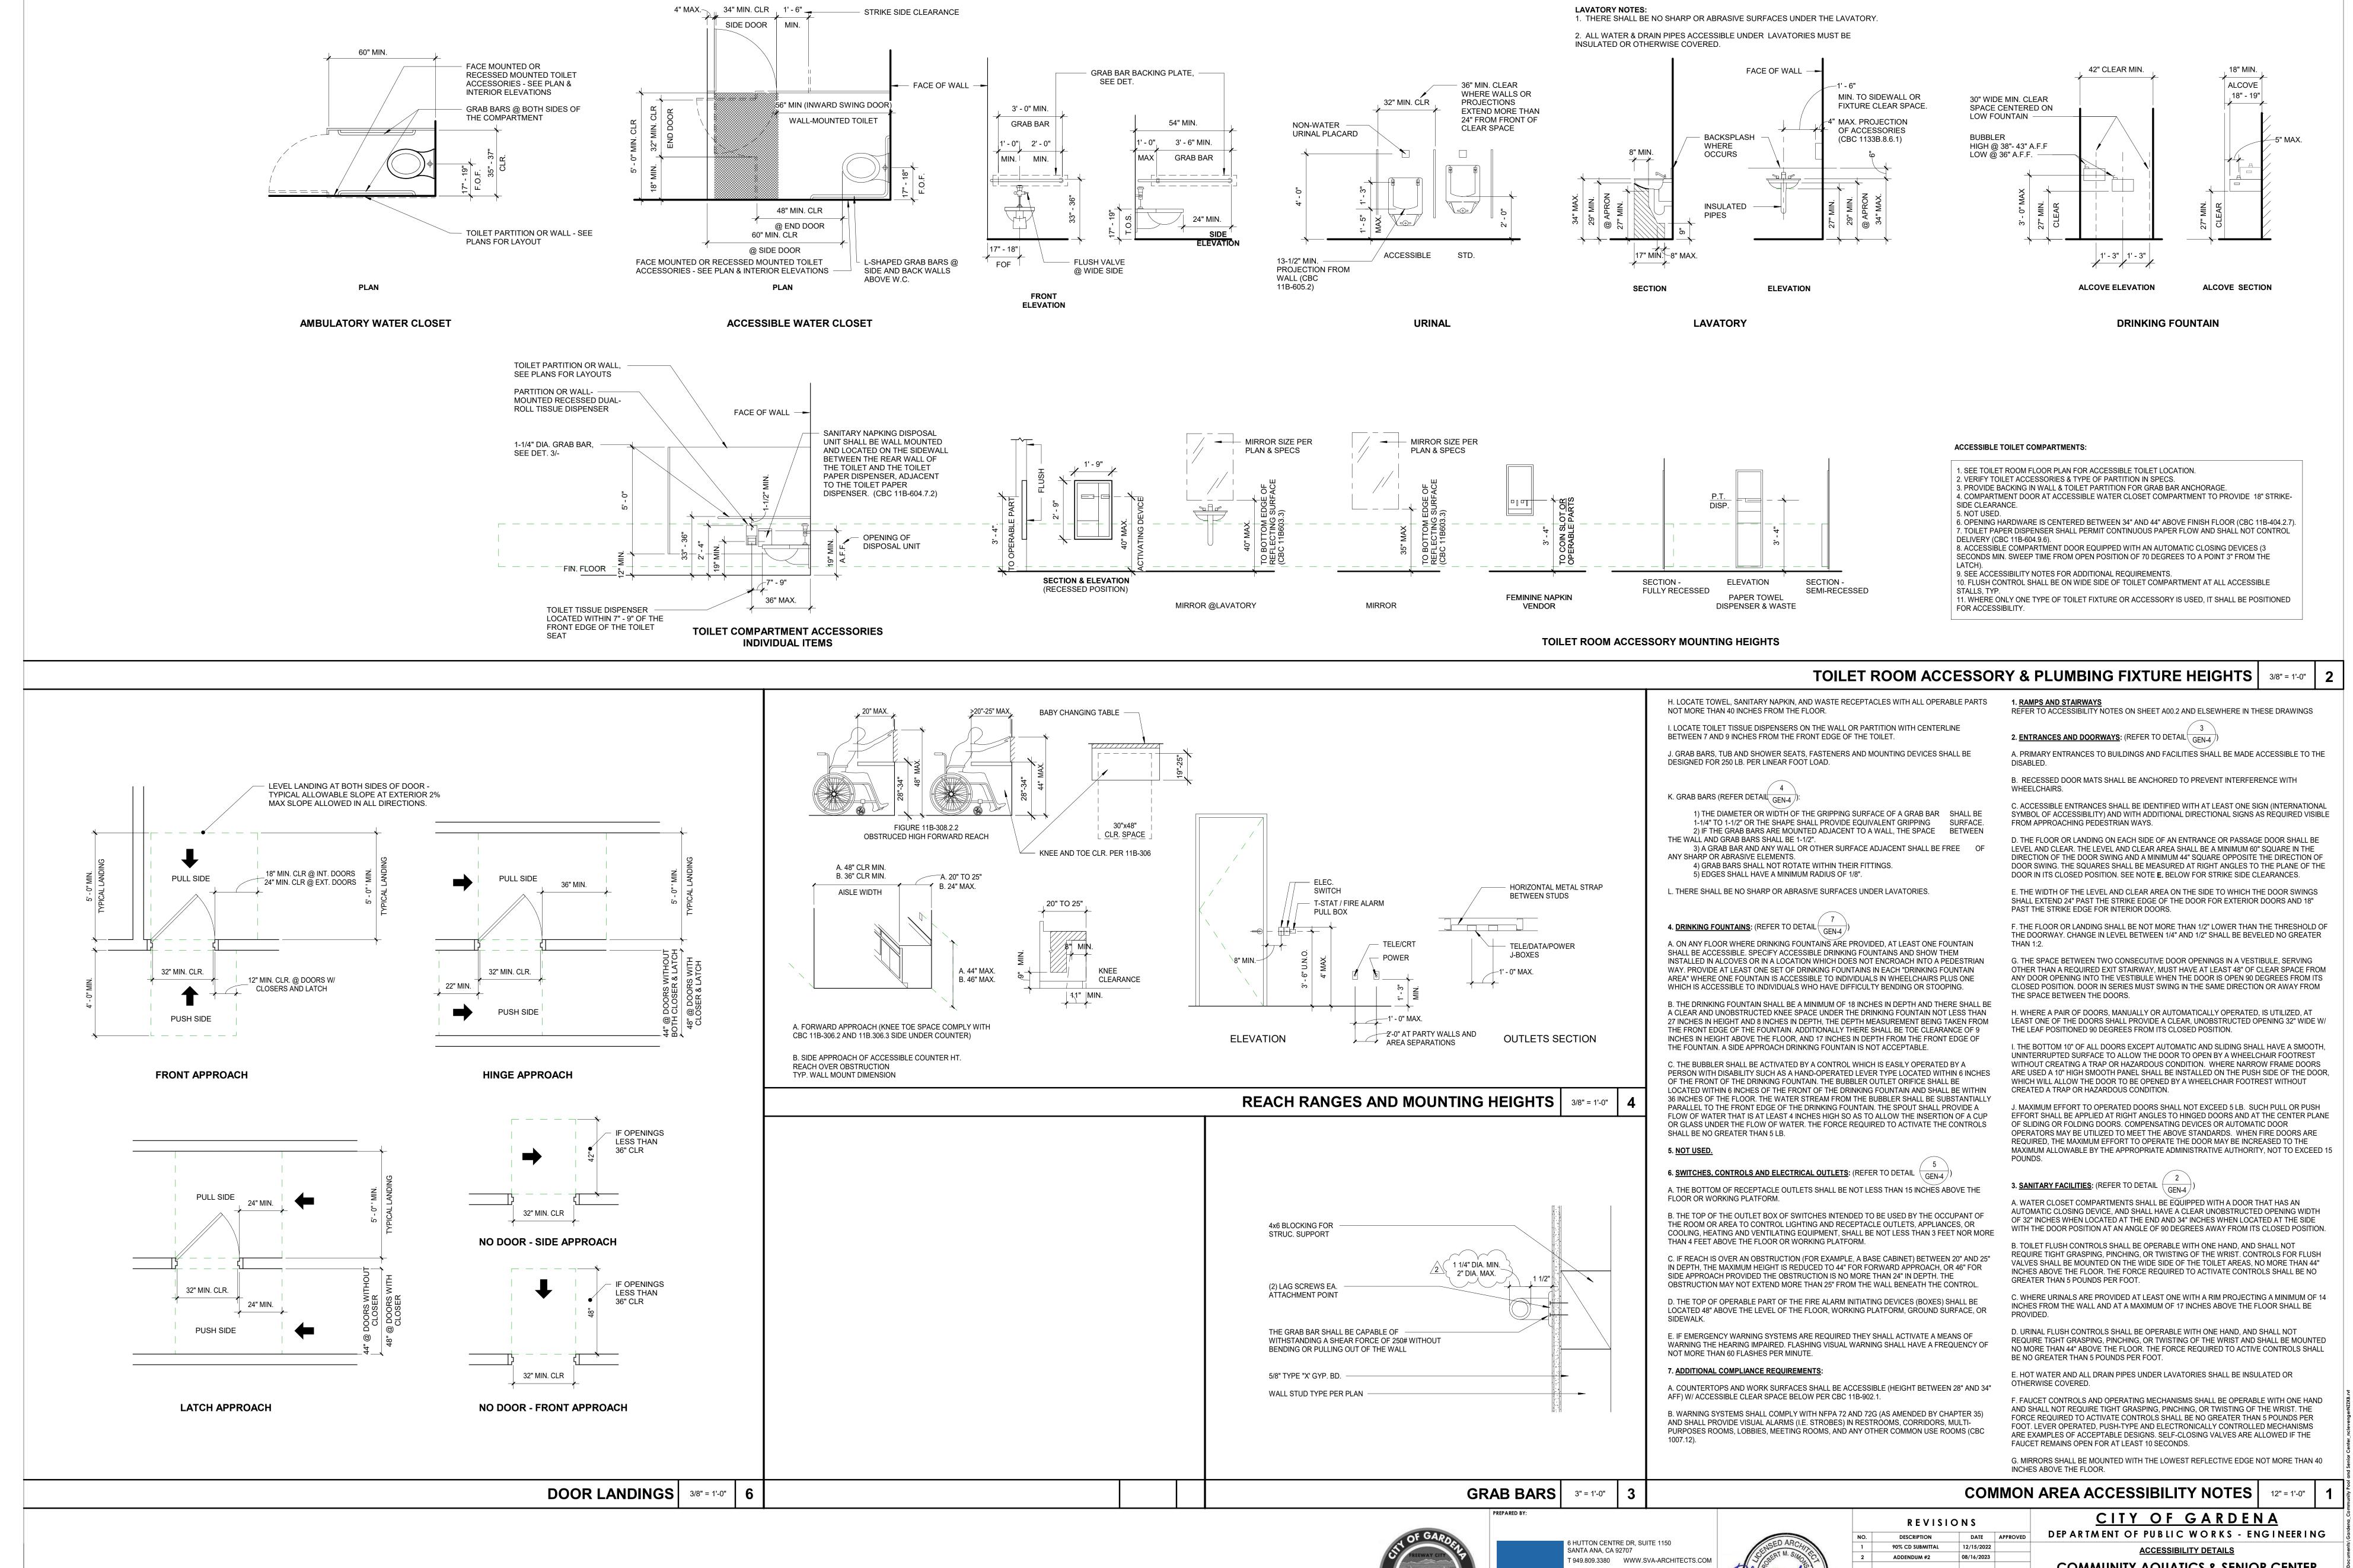



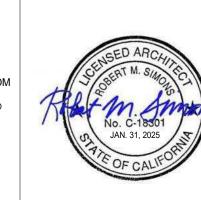

ELEV. = 43.508'

B.M.: THE CITY OF GARDENA BENCHMARK NO. 5D-15


**COMMUNITY AQUATICS & SENIOR CENTER** 


DESIGNED BY


DRAWN BY


CHECKED BY

AP/EC 05/25/2022 06/20/23 DIRECTOR OF PUBLIC WORKS 06/29/23 43 OF 176 DWG. NO. 5-2606

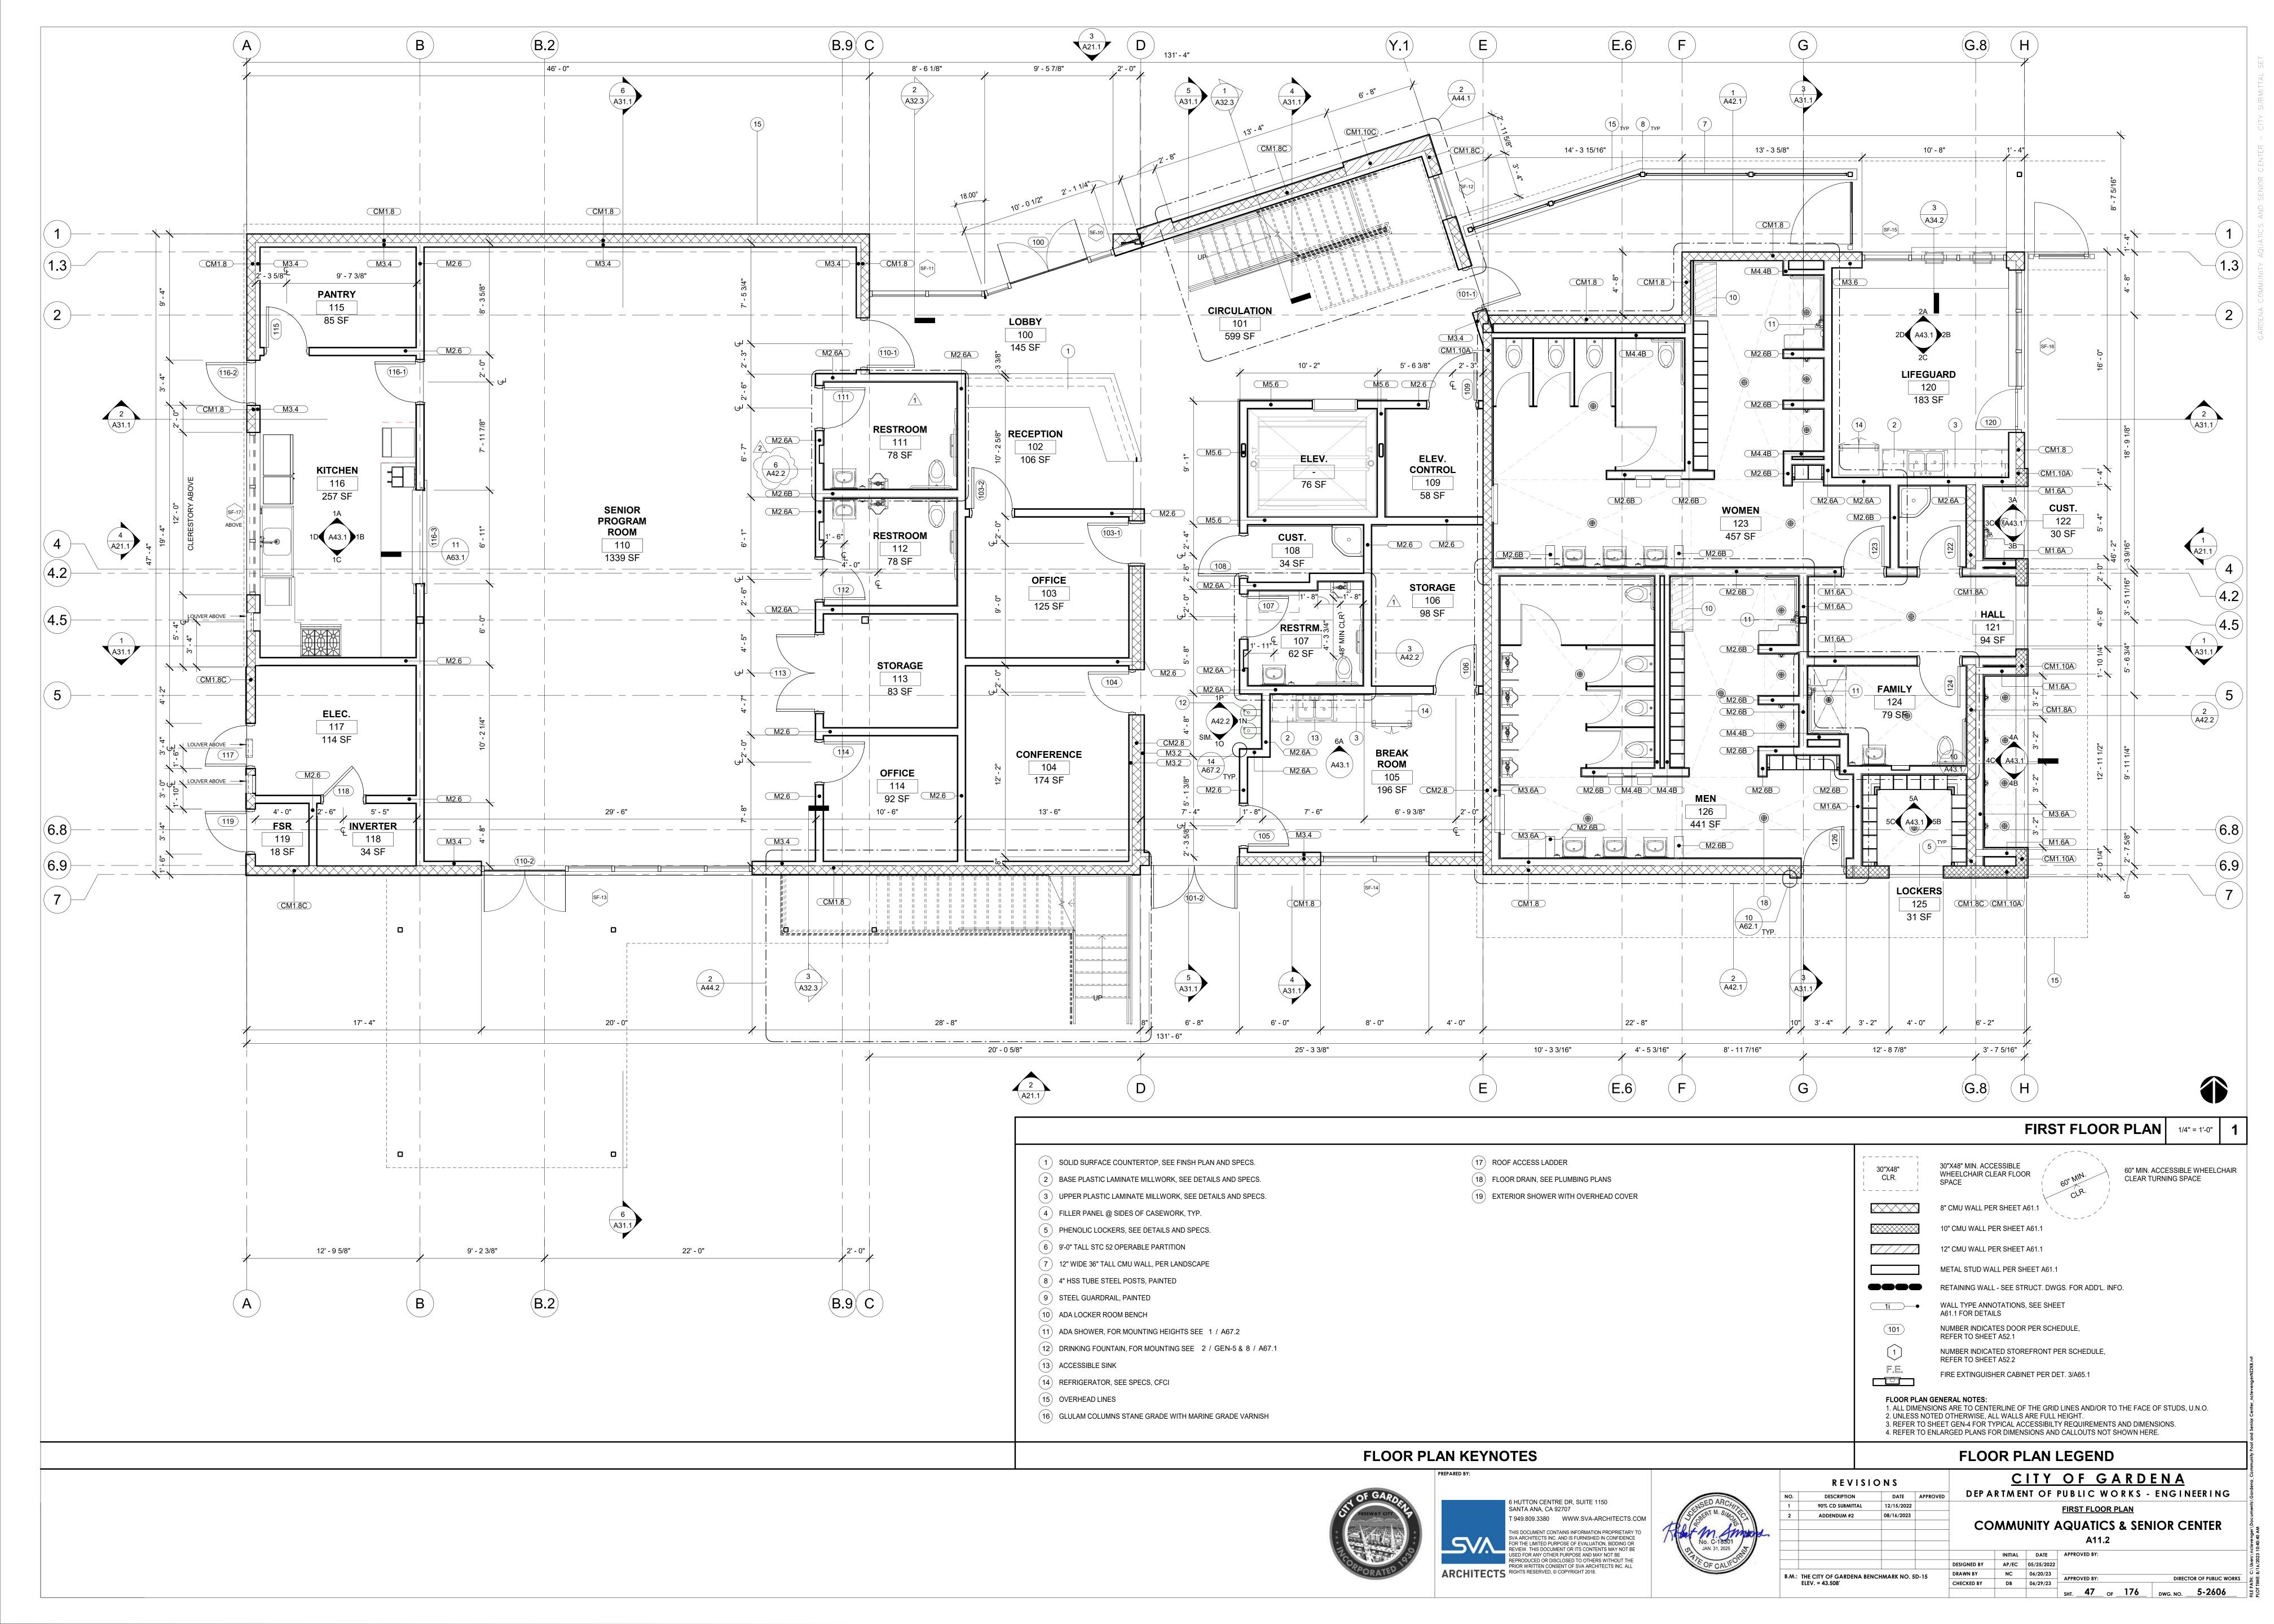

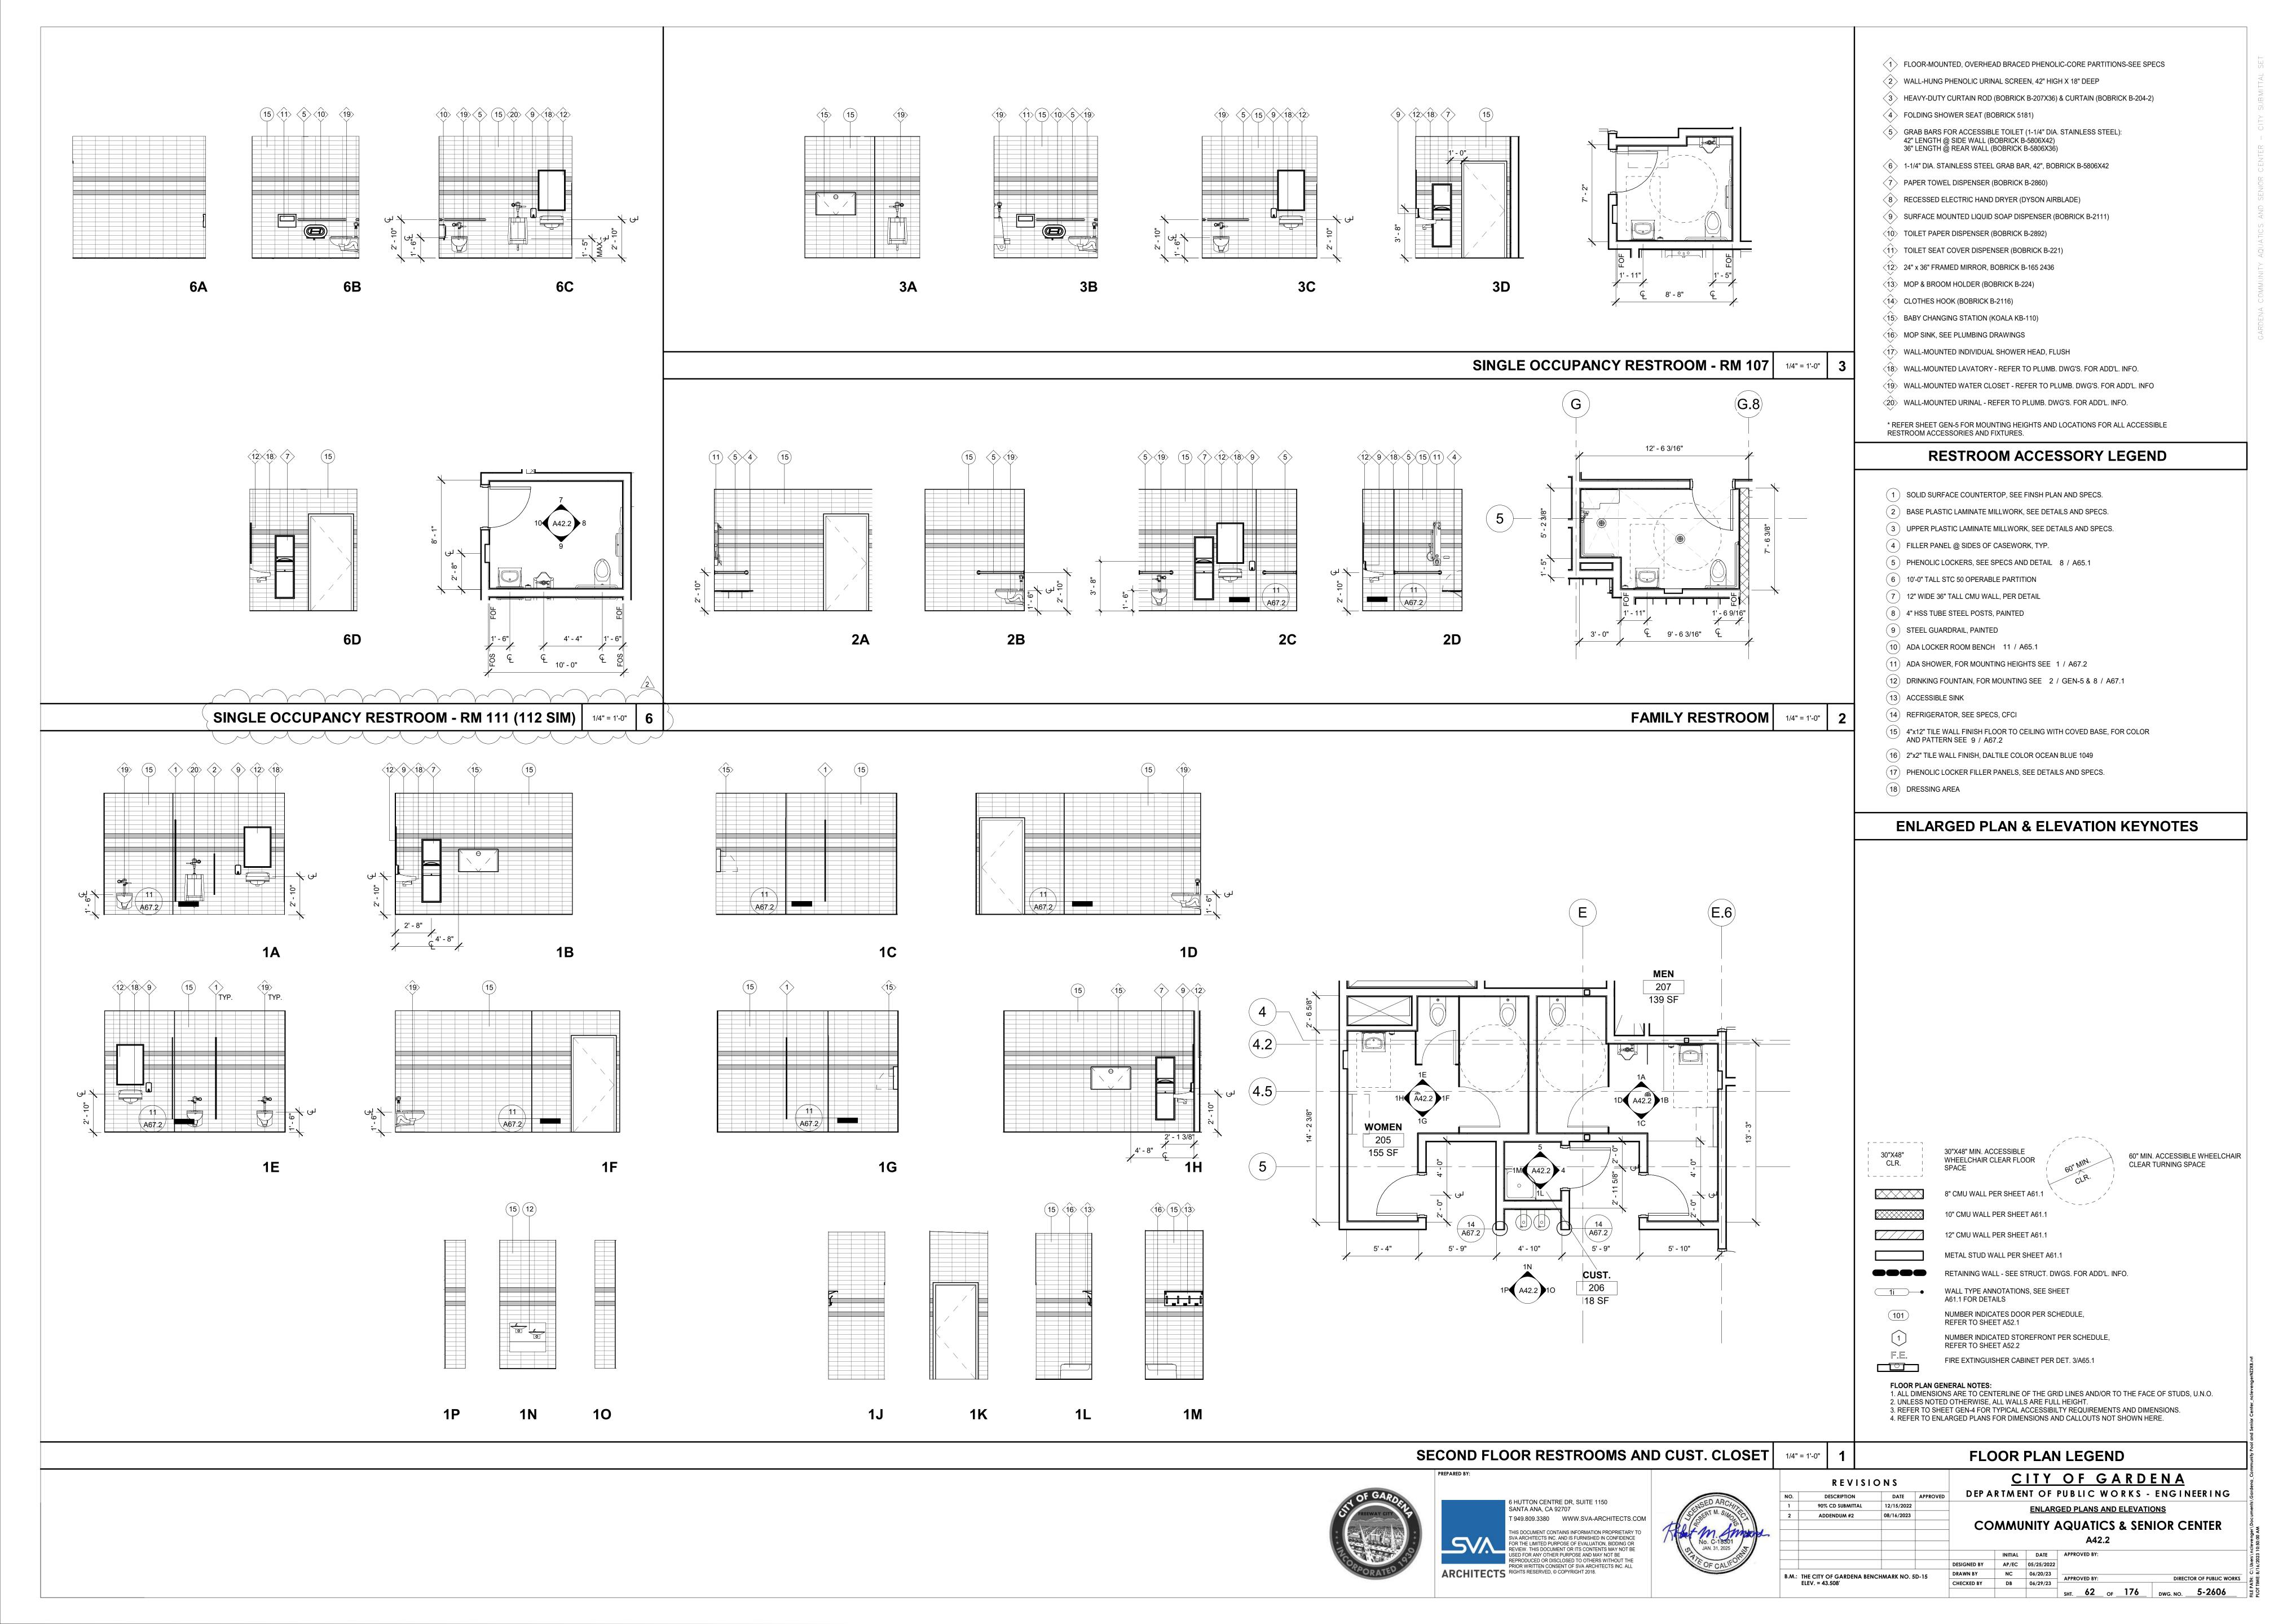

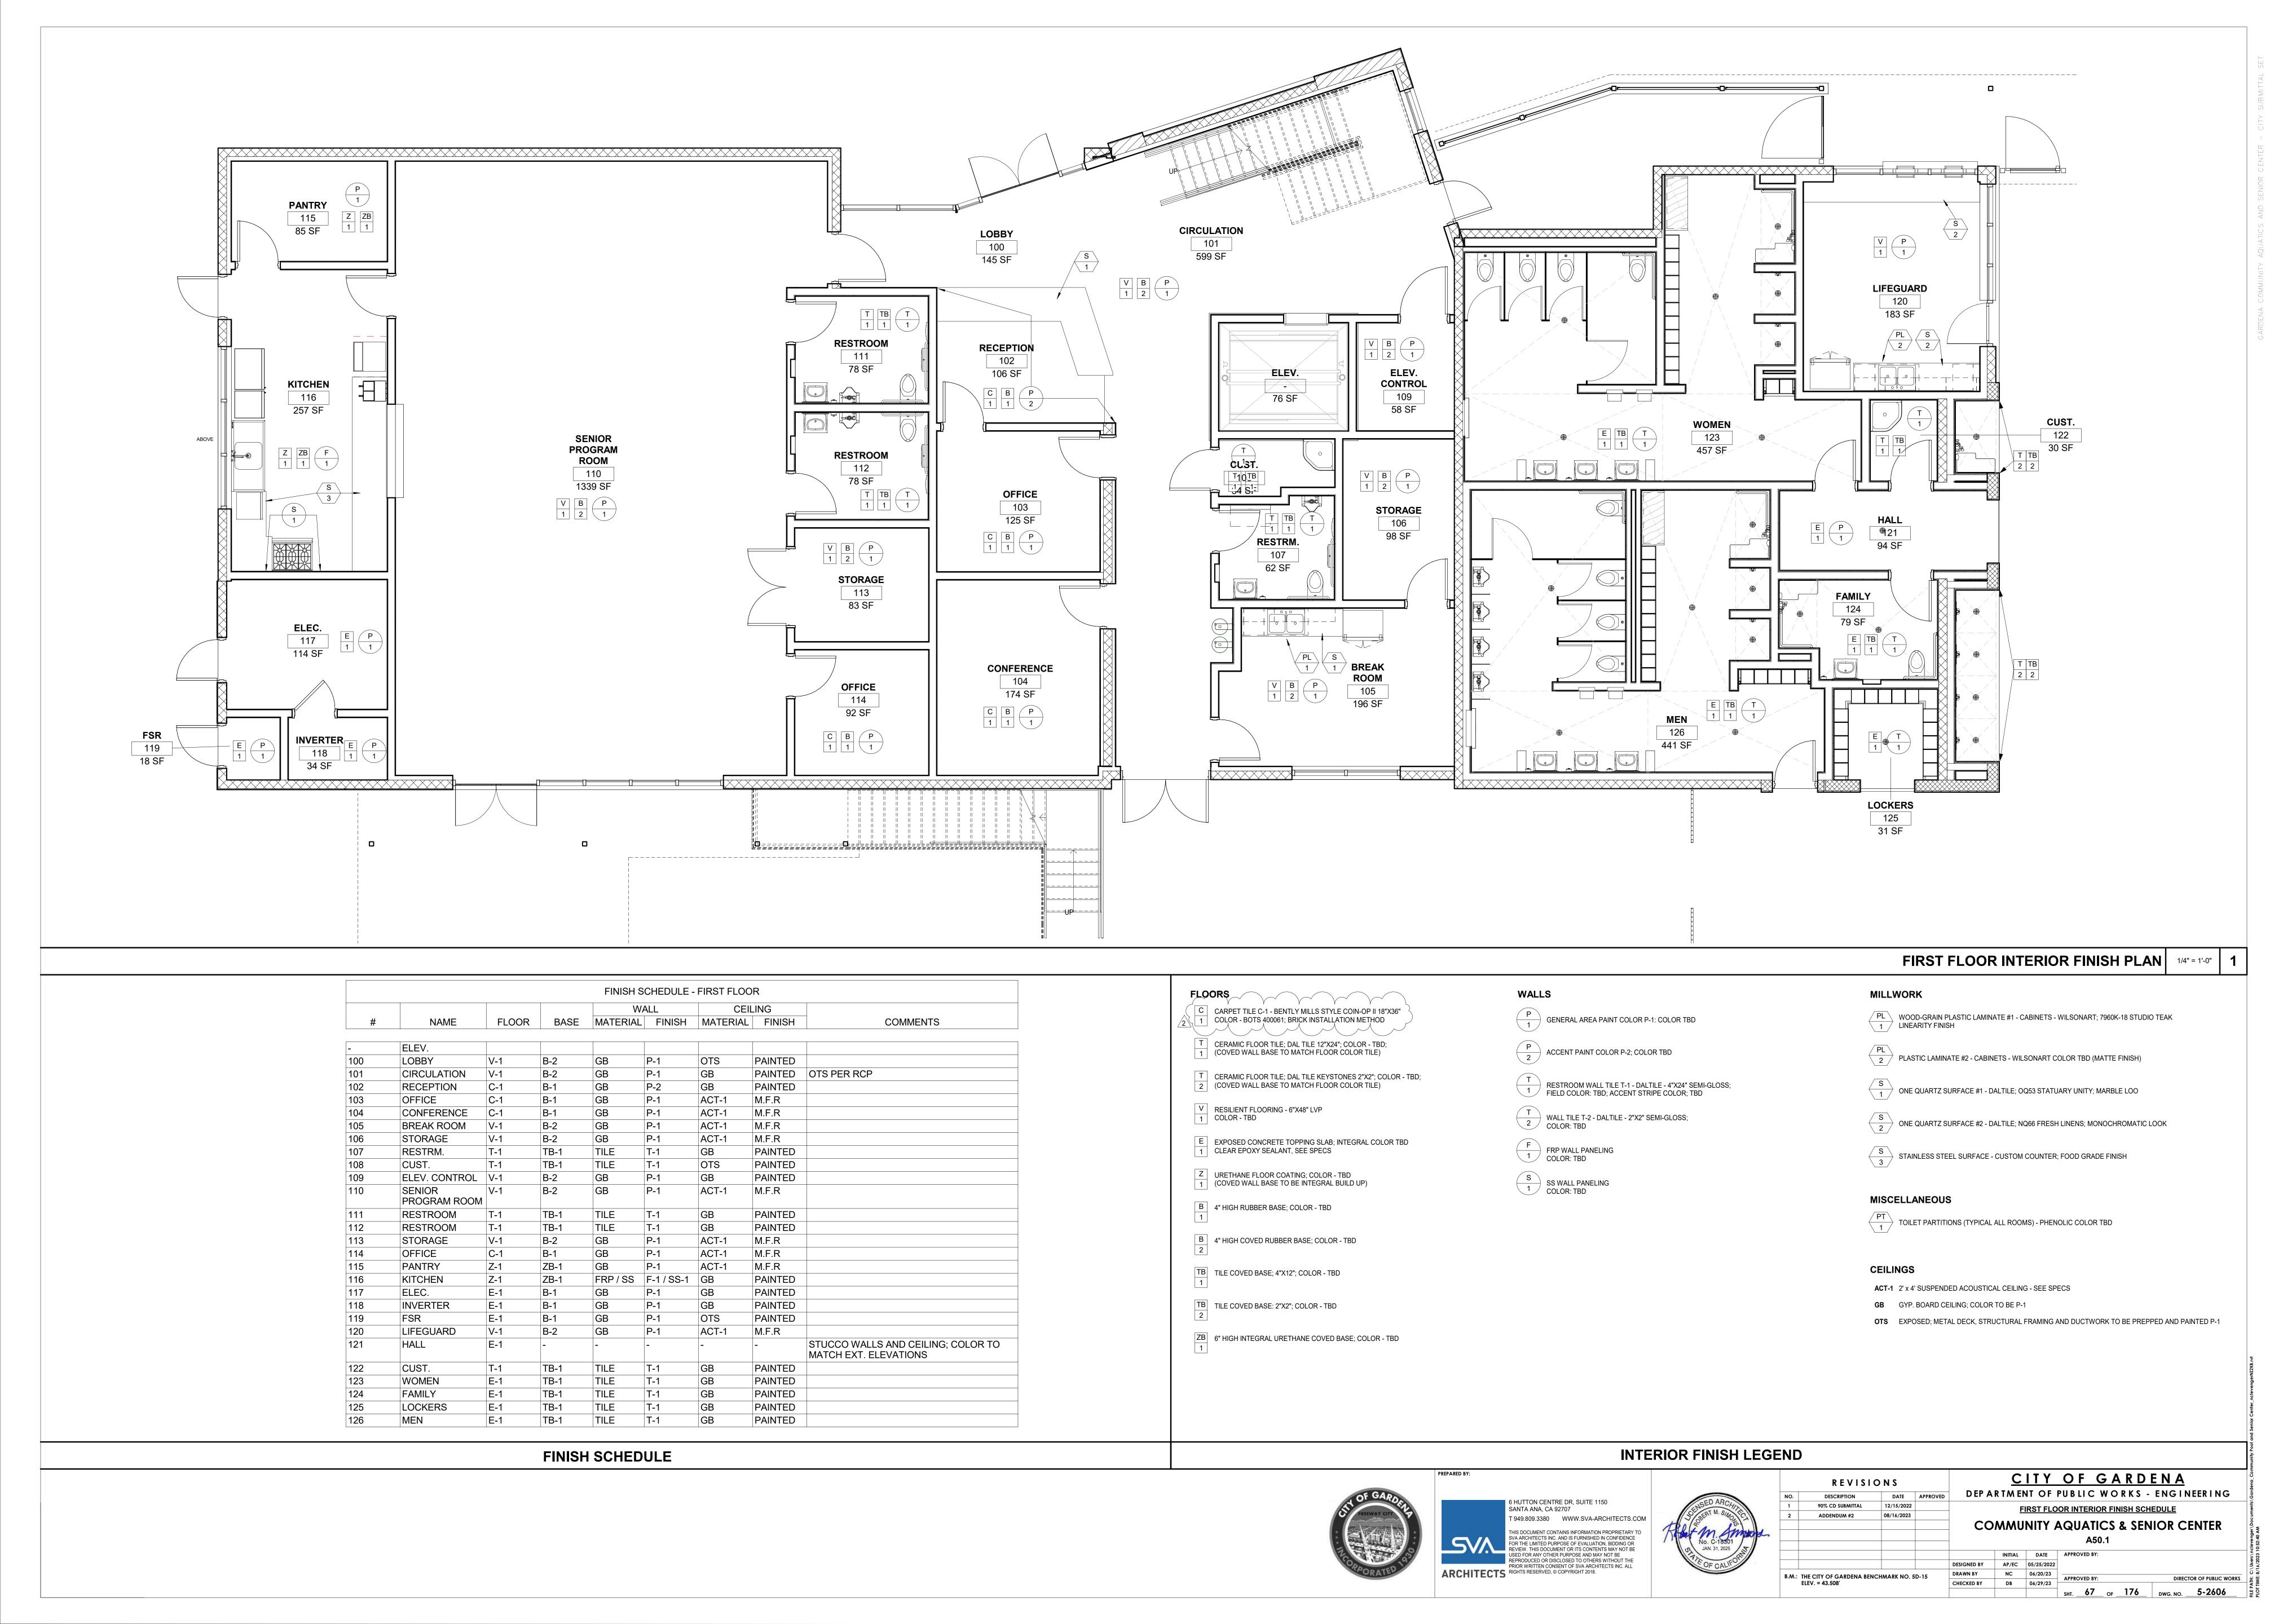

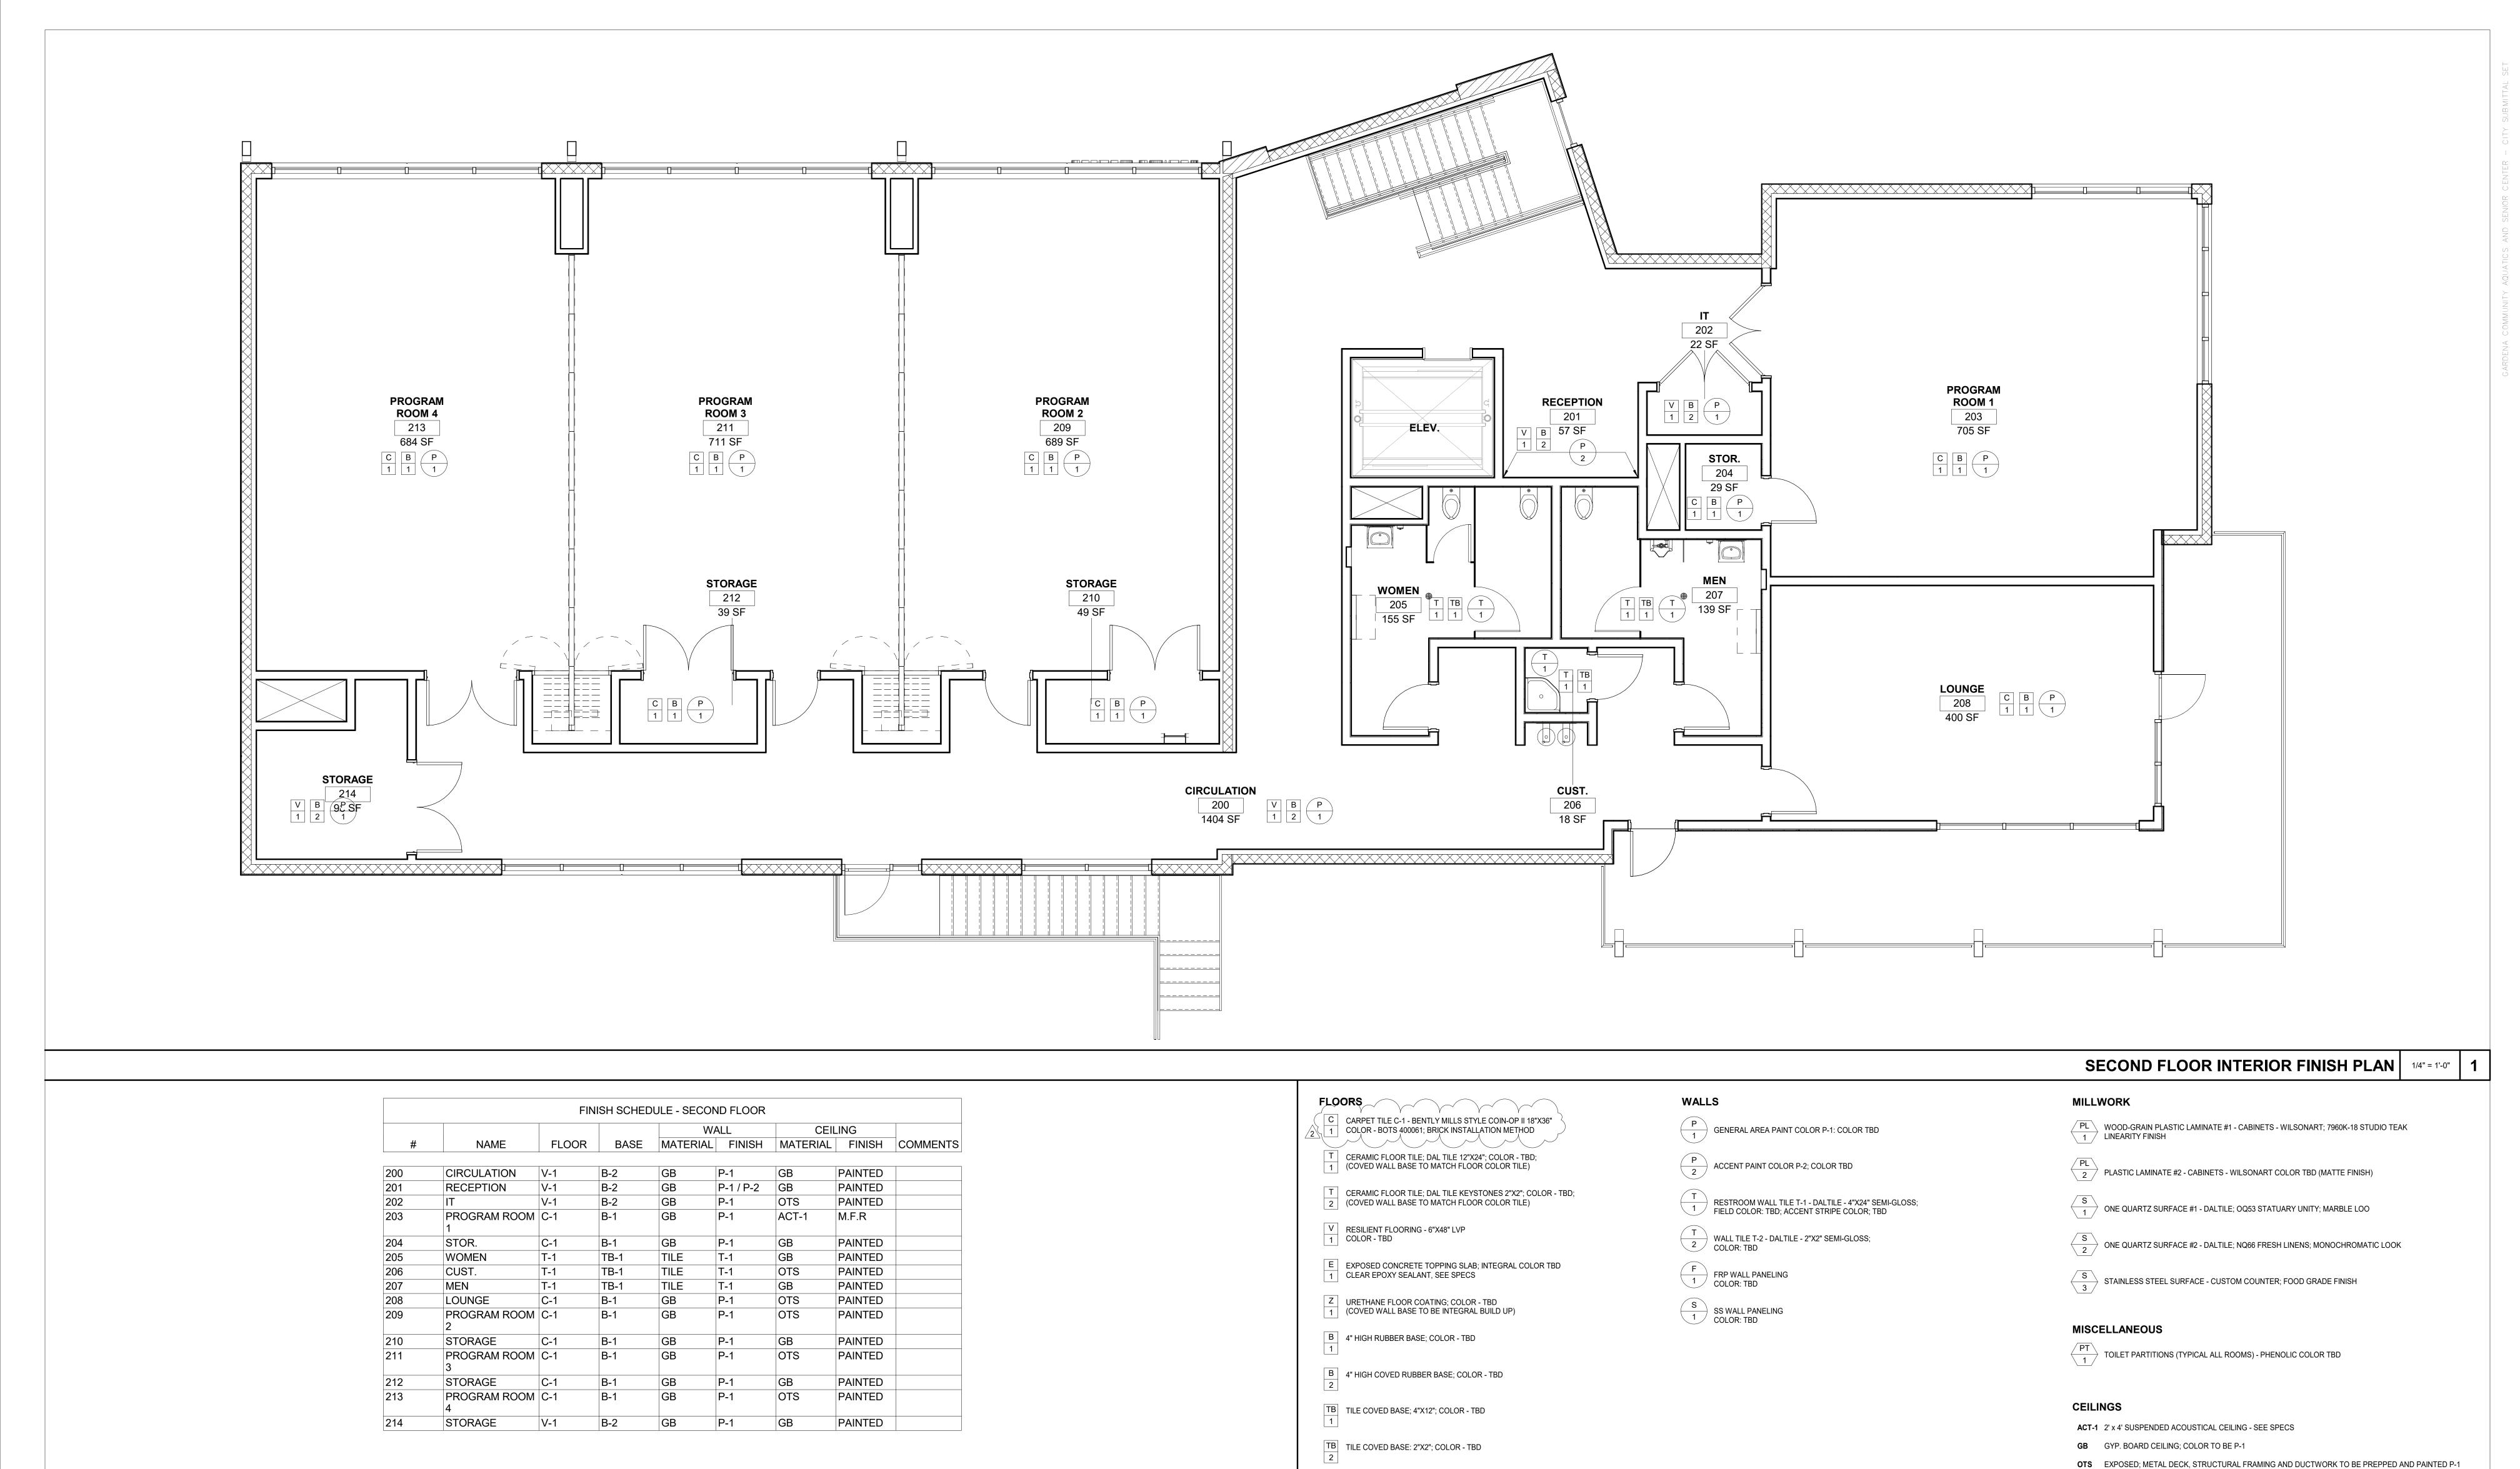

FINISH SCHEDULE

OF GARDEN PROPERTY OF GARD PROPERTY OF GARD PROPERTY OF GARD PROPERTY

ZB 6" HIGH INTEGRAL URETHANE COVED BASE; COLOR - TBD





**INTERIOR FINISH LEGEND** 

| REVISIONS           NO.         DESCRIPTION         DATE         A           1         90% CD SUBMITTAL         12/15/2022 |                  |            |   |  |  |  |  |  |  |  |  |
|----------------------------------------------------------------------------------------------------------------------------|------------------|------------|---|--|--|--|--|--|--|--|--|
| NO.                                                                                                                        | DESCRIPTION      | DATE       | , |  |  |  |  |  |  |  |  |
| 1                                                                                                                          | 90% CD SUBMITTAL | 12/15/2022 |   |  |  |  |  |  |  |  |  |
| 2                                                                                                                          | ADDENDUM #2      | 08/16/2023 |   |  |  |  |  |  |  |  |  |
|                                                                                                                            |                  |            |   |  |  |  |  |  |  |  |  |
|                                                                                                                            |                  |            |   |  |  |  |  |  |  |  |  |
|                                                                                                                            |                  |            | Г |  |  |  |  |  |  |  |  |
|                                                                                                                            |                  |            | - |  |  |  |  |  |  |  |  |

CITY OF GARDENA


DEPARTMENT OF PUBLIC WORKS - ENGINEERING

SECOND FLOOR INTERIOR FINISH SCHEDULE

COMMUNITY AQUATICS & SENIOR CENTER

|              |                    |                        |            |               |               |          |               |                      |                          | DOOR               | SCHEDULE |                                         |             |                                    |
|--------------|--------------------|------------------------|------------|---------------|---------------|----------|---------------|----------------------|--------------------------|--------------------|----------|-----------------------------------------|-------------|------------------------------------|
|              |                    |                        |            | DOOR          |               | FRA      | ME            | HEAD                 | DETAILS                  |                    | HARI     | DWARE                                   |             |                                    |
| NUMBER       | WIDTH              | HEIGHT                 | TYPE       | MATERIAL      | FINISH        | MATERIAL | FINISH        | DETAIL               | JAMB                     | THRESHOLD          | GROUP    | PH                                      | FIRE RATING | REMARKS                            |
| )            | 6' - 0"            | 8' - 0"                | FG-FG      | AL/GL         | AC            | AL       | AC            | 13/A63.1             | 13/A63.1                 | 5/A63.2            | 05       | YES                                     | NR          | CR, AO                             |
| 1-1          | 3' - 0"            | 8' - 0"                | FG         | AL/GL         | AC            | AL       | AC            | 15/A63.1             | 15/A63.1                 | 5/A63.2            | 01       | YES                                     | NR          | CR, AO                             |
| 01-2         | 6' - 4"            | 7' - 10"               | FG-FG      | AL/GL         | AC            | AL       | AC            | 12/A63.1             | 12/A63.1                 | 5/A63.2            | 05       | YES                                     | NR          | CR, AO                             |
| 03-1         | 3' - 0"            | 7' - 0"                | FG         | AL/GL         | AC            | AL       | AC            | 4/A63.1              | 4/A63.1                  | 9/A63.1            | <u> </u> |                                         | NR          | CR                                 |
| 03-2         | 3' - 0"            | 7' - 0"                | FG         | AL/GL         | AC            | AL       | AC            | 4/A63.1              | 4/A63.1                  | 9/A63.1            | 16 /     |                                         | NR          | CR                                 |
| 04           | 3' - 0"            | 7' - 0"                | FG         | AL/GL         | AC            | AL       | AC            | 4/A63.1              | 4/A63.1                  | 9/A63.1            | 14       | 1)                                      | NR          | CR CR                              |
| 05           | 3' - 0"            | 7' - 0"                | FG         | AL/GL         | AC P          | AL       | AC            | 4/A63.1              | 4/A63.1                  | 9/A63.1            | 14       | 4                                       | NR          | CR CP                              |
| 06<br>07     | 3' - 0"<br>3' - 0" | 7' - 0"<br>7' - 0"     | F          | SCW<br>SCW    | Р             | AL<br>AL | AC<br>AC      | 4/A63.1<br>4/A63.1   | 4/A63.1<br>4/A63.1       | 9/A63.1<br>9/A63.1 | 17 24    |                                         | NR<br>NR    | CR                                 |
| 08           | 3' - 0"            | 7' - 0"                | F          | SCW           | <u>г</u><br>Р | AL       | AC            | 4/A63.1              | 4/A63.1                  | 9/A63.1            | 28       |                                         | NR          |                                    |
| 09           | 3' - 6"            | 7' - 0"                | F          | SCW           | <u>'</u><br>Р | AL       | AC            | 4/A63.1              | 4/A63.1                  | 9/A63.1            | 32       | 1                                       | NR          |                                    |
| 10-1         | 3' - 6"            | 7' - 0"                | FG         | AL/GL         | AC            | HM       | P             | 1/A63.1              | 1/A63.1                  | 9/A63.1            | 13       | YES                                     |             | CR, AO                             |
| 10-2         | 6' - 0"            | 7' - 0"                | FG-FG      | AL/GL         | AC            | AL       | AC            | 13/A63.1             | 13/A63.1                 | 5/A63.2            | 05       |                                         |             | CR, AO                             |
| 11           | 3' - 0"            | 7' - 0"                | F          | SCW           | P             | HM       | P             | 1/A63.1              | 1/A63.1                  | 9/A63.1            | 25       |                                         | NR          | •                                  |
| 12           | 3' - 0"            | 7' - 0"                | F          | SCW           | Р             | HM       | Р             | 1/A63.1              | 1/A63.1                  | 9/A63.1            | 25       | 7                                       | NR          |                                    |
| 13           | 5' - 8"            | 7' - 0"                | F-F        | SCW           | Р             | HM       | Р             | 1/A63.1              | 1/A63.1                  | 9/A63.1            | 22       |                                         | NR          | CR                                 |
| 14           | 3' - 0"            | 7' - 0"                | FG         | AL/GL         | AC            | AL       | AC            | 4/A63.1              | 4/A63.1                  | 9/A63.1            | 14       |                                         | NR          | CR                                 |
| 15           | 3' - 0"            | 7' - 0"                | F          | SCW           | Р             | HM       | Р             | 1/A63.1              | 1/A63.1                  | 9/A63.1            | 17       |                                         | NR          | CR                                 |
| 16-1         | 3' - 0"            | 7' - 0"                | N          | SCW/GL        | Р             | HM       | Р             | 1/A63.1              | 1/A63.1                  | 9/A63.1            | 14       |                                         |             | CR                                 |
| 16-2         | 3' - 0"            | 8' - 0"                | F          | HM            | Р             | HM       | Р             | 2/A63.1              | 2/A63.1                  | 7/A63.1            | 07       | YES                                     | NR          | CR                                 |
| 16-3         | 6' - 11"           | 8' - 0"                | OR         | AL            | AC            | SS       | FF            | -                    | -                        | - (                | 18       | 1                                       | NR          | OVER HEAD ROLLING COUNTER DOOR     |
| 17           | 3' - 0"            | 8' - 0"                | F          | HM            | P             | HM       | P             | 6/A63.1              | 3/A63.1                  | 7/A63.1            | 08       | <u> </u>                                | NR          |                                    |
| 18           | 3' - 0"            | 7' - 0"                | <b> </b>   | HM            | P             | HM       | Р             | 1/A63.1              | 1/A63.1                  | 9/A63.1            | 29       |                                         | NR          |                                    |
| 19           | 3' - 0"<br>3' - 0" | 8' - 0"<br>7' - 9 1/2" | FG         | HM<br>AL/GL   | · ·           | HM       | '             | 6/A63.1              | 3/A63.1<br>12,13/A63.1   | 7/A63.1<br>5/A63.2 | 08       |                                         | NR<br>NR    | CR CR                              |
| 20<br>22     | 3' - 0"            | 7 - 9 1/2              | FG         | HM            | AC            | AL<br>HM | AC            | 12/A63.1<br>14/A63.1 | 12, 13/A63.1<br>14/A63.1 | 9/A63.2            | 30       |                                         | NR          | OK .                               |
| 23           | 3' - 0"            | 7' - 0"                | F          | HM            | <u>'</u><br>Р | HM       | P             | 14/A63.1             | 14/A63.1                 | 9/A63.2            | > 26 <   | +                                       | NR          |                                    |
|              | 3' - 0"            | 7' - 0"                | F.         | HM            | <br>Р         | HM       | <br>Р         | 14/A63.1             | 14/A63.1                 | 9/A63.2 /          | 25       |                                         | NR          |                                    |
| 26           | 3' - 0"            | 8' - 0"                | F          | HM            | <u>.</u><br>Р | HM       | P             | 2/A63.1              | 2/A63.1                  | 7/A63.1            | 26       |                                         | NR          |                                    |
| 00-1         | 3' - 0"            | 8' - 0"                | FG         | AL/GL         | AC            | AL       | AC            | 12/A63.2             | 11/A63.2                 | 7/A63.1 SIM        | 02       | 1)                                      | NR          |                                    |
| 00-2         | 3' - 0"            | 7' - 7"                | FG         | AL/GL         | AC            | AL       | AC            | 15/A63.1             | 13/A63.1                 | 10/A63.1           | > 03 <   | YES                                     | NR          | CR                                 |
| 02           | 6' - 0"            | 7' - 0"                | F-F        | SCW           | Р             | AL       | AC            | 4/A63.1              | 4/A63.1                  | 9/A63.1 (          | 34       |                                         | NR          |                                    |
| 03           | 6' - 0"            | 7' - 0"                | N-N        | SCW/GL        | Р             | HM       | Р             | 1/A63.1              | 1/A63.1                  | 9/A63.1            | 21       | YES                                     |             | CR                                 |
|              | 3' - 0"            | 7' - 0"                | F          | SCW           | Р             | AL       | AC            | 4/A63.1              | 4/A63.1                  | 9/A63.1            | ( 15     | <u>/</u>                                |             | CR                                 |
|              | 3' - 0"            | 7' - 0"                | F          | SCW           | Р             | AL       | AC            | 4/A63.1              | 4/A63.1                  | 9/A63.1            | > 27 <   |                                         | NR          |                                    |
| 06           | 3' - 0"            | 7' - 0"                | F          | SCW           | P             | AL       | AC            | 4/A63.1              | 4/A63.1                  | 9/A63.1            | 31 (     |                                         | NR          |                                    |
| 07           | 3' - 0"            | 7' - 0"                | FC         | SCW           | P             | AL       | AC            | 4/A63.1              | 4/A63.1                  | 9/A63.1            | 27       | 1)                                      | NR          | OD.                                |
| 08-1<br>08-2 | 3' - 0"<br>3' - 0" | 7' - 0"                | FG<br>FG   | AL/GL         | AC            | AL       | AC            | 4/A63.1              | 4/A63.1                  | 9/A63.1            | 14       | 4                                       |             | CR<br>CR                           |
|              | 3 - 0              | 8' - 0"                |            | AL/GL         | AC            | AL       | AC            | 13/A63.1             | 13/A63.1,<br>11/A63.2    | 5/A63.2 SIM        | 03       |                                         | NR          |                                    |
| 09           | 3' - 0"            | 7' - 0"                | N          | SCW/GL        | Р             | AL       | AC            | 4/A63.1              | 4/A63.1                  | 9/A63.1            | 19       | YES                                     |             | CR                                 |
| 10-1         | 6' - 0"            | 7' - 0"                | F-F        | SCW           | Р             | AL       | AC            | 4/A63.1              | 3/A63.1                  | 9/A63.1            | 23       | 1                                       |             | CR                                 |
|              | 3' - 0"            | 1' - 0 19/32"          | RH         | ST            | FF            | ST       | FF            | - 4/4.00 /           | -                        | -                  | > 33     | \ \ \ \ \ \ \ \ \ \ \ \ \ \ \ \ \ \ \ \ |             | ROOF ACCESS HATCH                  |
|              | 3' - 0"            | 7' - 0"                | N          | SCW/GL        | P             | AL       | AC            | 4/A63.1              | 4/A63.1                  | 9/A63.1            | 19 <     | YES                                     |             | CR CP                              |
| 12           | 6' - 0"            | 7' - 0"                | F-F        | SCW           | <u>Р</u>      | AL       | AC            | 4/A63.1              | 4/A63.1                  | 9/A63.1            | 22       | VEC                                     | NR<br>NB    | CR CR                              |
| 13<br>14     | 6' - 0"<br>6' - 0" | 7' - 0"<br>7' - 0"     | N-N<br>F-F | SCW/GL<br>SCW | <u>Р</u>      | AL       | AC            | 4/A63.1              | 4/A63.1                  | 9/A63.1<br>9/A63.1 | 20       | YES                                     | NR          | CR                                 |
| 01           | 3' - 0"            | 7' - 0"                | F-F        | HM            | Р             | AL<br>HM | AC<br>P       | 4/A63.1<br>6/A63.1   | 4/A63.1<br>3/A63.1       | 7/A63.1            | 09       | YES                                     | NR<br>NR    |                                    |
| 02           | 5' - 8"            | 7'-0"                  | F-F        | HM            | <u>Р</u>      | HM       | p             | 6/A63.1              | 3/A63.1                  | 7/A63.1            | 06       | 113                                     |             | CR CR                              |
| 03           | 5' - 8"            | 7' - 0"                | F-F        | HM            | <u>г</u><br>Р | HM       | <u>г</u><br>Р | 6/A63.1              | 3/A63.1                  | 7/A63.1            | 11       | <del> </del>                            | NR          |                                    |
| 04           | 5' - 8"            | 7' - 0"                | L-L        | HM            | P             | HM       | '<br>P        | 6/A63.1              | 3/A63.1                  | 7/A63.1            | 11       |                                         | NR          |                                    |
| 05           | 5' - 8"            | 7' - 0"                | L-L        | HM            | <br>P         | HM       | <br>P         | 6/A63.1              | 3/A63.1                  | 7/A63.1            | 11       |                                         | NR          |                                    |
|              | 3' - 0 3/4"        | 6' - 10"               | G-EE       | ST            | Р             | ST       | Р             | -                    | 7/A40.2                  | -                  | > 10     | YES                                     |             | PEDESTRIAN GATE AT TRASH ENCLOSURE |
| 06-3         | 8' - 0"            | 6' - 10"               | G-DD       | ST            | Р             | ST       | Р             | _                    | 7/A40.2                  | _                  | 12       | 1                                       | NR          | BIN GATE AT TRASH ENCLOSURE        |


DOOR SCHEDULE

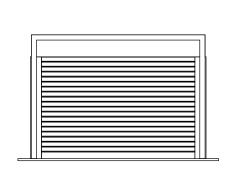



**OR** OVERHEAD ROLLING




RH ROOF HATCH

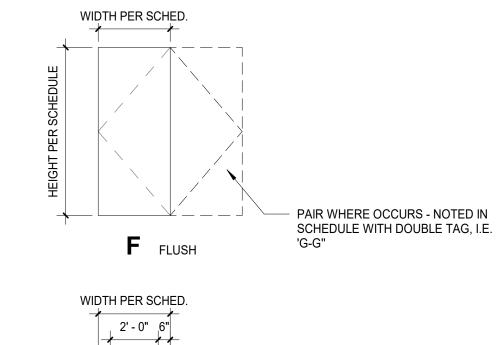

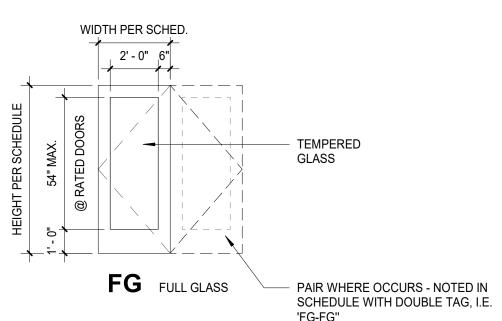

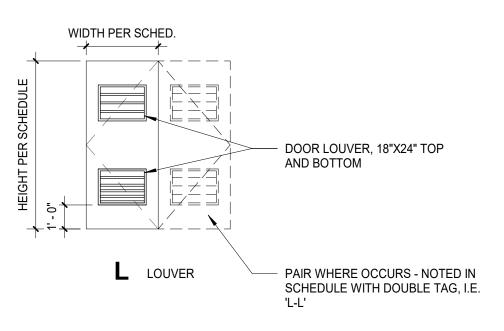

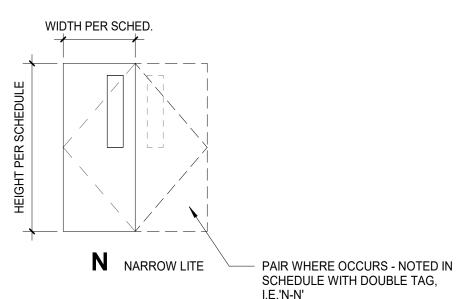

### **COMMENTS:**

1. PROVIDE ELECTRONIC HOLD-OPENS FOR EACH LEAF W/ CONNECTION TO FIRE ALARM. 2. EXISTING DOOR TO REMAIN. 3. EXISTING COPPER-CLAD DOOR TO REMAIN - CONTRACTOR TO INCLUDE \$5,000 ALLOWANCE FOR REPAIR OF EXISTING METAL.

## DOOR COMMENTS LEGEND

ALUMINUM ANODIZED CLEAR AO - AUTOMATIC OPENER ANODIZED BRONZE CC - CONCEALED CLOSER CLR - CLEAR CR - CARD READER / ACCESS CONTROL FC - FLOOR CLOSER FACTORY FINISH FUSIBLE LINK FIRE DAMPER FLFD -FP - FIELD PAINT FPFP - FACTORY PRIMED, FIELD PAINTED FRA - FIRE RATED ASSEMBLY FS - FIELD STAINED GALVANIZED GLASS OR GLAZING GALVANIZED STEEL **HOLLOW METAL** FLUOROPOLYMER FINISH (SEE SPECS) LOUVER LVR -MILL FINISH MR -MIRRORED GLASS MAGNETIC HOLD OPEN PAINTED (FOR EXISTING FRAMES - PAINT SHALL INCLUDE PREP AND REPAIR OF EXISTING FRAME, TYPICAL PAINT GRADE PANIC HARDWARE PR -SOLID CORE WOOD SG - STAIN GRAIN SMC - SURFACE MOUNTED CLOSER ST - STEEL

## DOOR NOTES LEGEND

1. LETTER "P" FOLLOWING DOOR TYPE LETTER IN SCHEDULE INDICATES A PAIR OF DOORS. SCHEDULED DIMENSION IS TOTAL FRAME OPENING. BOTH DOOR LEAVES ARE THE SAME SIZE UNLESS OTHERWISE

2. LETTER "X" FOLLOWING DOOR TYPE LETTER IN SCHEDULE INDICATES A FIXED PANEL ABOVE DOOR LEAF. DOOR LEAF IS TO BE 7'-0" HIGH. SCHEDULED DIMENSION IS HEIGHT OF ACTIVE DOOR LEAF PLUS FIXED PANEL. FIXED PANEL SHALL BE OF SAME MATERIAL, CONSTRUCTION, THICKNESS, AS FINISH AS ACTIVE DOOR AND PROVIDED BY THE SAME MANUFACTURER AS DOOR.

3. LOUVERS IN FIRE-RATED DOOR ASSEMBLIES TO BE FLFD (FUSIBLE LINK FIRE DAMPER), LOUVERS IN EXTERIOR DOORS TO BE VANDAL-PROOF SECURITY TYPE. 4. GLAZING, ALL GLAZING PANELS IN FIRE-RATED DOOR ASSEMBLIES TO BE RATED GLASS. ALL OTHER

GLAZING PANELS IN DOORS TO BE TEMPERED GLASS UNLESS OTHERWISE NOTED. 5. ALL DOORS NOTED AS 1-HOUR, AND 1 1/2-HOUR FIRE-RATED ASSEMBLIES SHALL MEET THE ADDITIONAL REQUIREMENTS OF MAXIMUM 450 F TEMPERATURE RISE ABOVE AMBIENT AFTER 30 MINUTES OF THE FIRE TEST. (CBC SEC. 1005.3.3.5 AND 1005.3.4.4).

6. THICKNESS: ALL DOORS TO BE 1 3/4" THICK UNLESS OTHERWISE NOTED.

7. ALL EXTERIOR DOORS TO HAVE WEATHERSTRIPPING ALL SIDES PER TITLE 24, SECTION T20-1451-1542.

8. ALL WOOD DOORS TO BE SOLID-CORE TYPE.

SS - STAINLESS STEEL

TEMPERED

TEMP -

9. EXIT DOORS SERVING 50 OR MORE OCCUPANTS SHALL OPEN IN THE DIRECTION OF EXIT. 10. EVERY EXIT DOOR SHALL BE OPENABLE FROM THE INSIDE WITHOUT THE USE OF A KEY OR ANY SPECIAL KNOWLEDGE OR EFFORT. ANY SPECIAL LOCKING DEVICES SHALL BE OF THE APPROVED TYPE.

CBC CHAPTER 33 AND UFC SECTION 12,104(B). 11. DOOR HARDWARE SHALL COMPLY WITH THE FOLLOWING PER CBC 11B-404.2

1. OPERABLE BY A SIMPLE EFFORT, NOT GRASPING WRIST MOVEMENT (LEVERS, PANIC

DEVICES, OR PULLS). 2. 5-LB CLOSURE PRESSURE AT INTERIOR DOORS. 3. 5-LB CLOSURE PRESSURE AT EXTERIOR DOORS.

BE READILY DISTINGUISHABLE AS LOCKED.

4. 5-LB CLOSURE PRESSURE AT FIRE DOORS. 5. WHEN FIRE DOORS ARE REQUIRED, THE MAXIMUM EFFORT TO OPERATE THE DOOR MAY BE INCREASED TO THE MINIMUM ALLOWABLE BY THE APPROPRIATE ADMINISTRATIVE

AUTHORITY, NOT TO EXCEED 15 POUNDS. 12. ALL DOORS INDICATED AS FIRE-RATED ASSEMBLIES TO HAVE CLOSURES AND SMOKE SEALS.

13. ON DOORS IN ALUMINUM FRAMES, PROVIDE ARMORED STRIKE ON JAMB OF ALUMINUM FRAME.

14. EXIT DOORS SHALL HAVE A READILY VISIBLE, DURABLE SIGN ON OR ADJACENT TO THE DOOR STATING, "THIS DOOR TO REMAINED UNLOCKED DURING BUSINESS HOURS." THE SIGN SHALL HAVE 1" HIGH LETTERS ON A CONTRASTING BACKGROUND. THE LOCKING DEVICE MUST BE OF A TYPE THAT WILL

15. DOORS SHALL BE A MINUMUM OF 36" WIDE X 80" HIGH WITH NO SINGLE LEAF EXCEEDING 4'-0" IN

16. BOTTOM 10" OF DOOR TO HAVE SMOOTH UNINTERUPTED SURFACE FOR OPENING BY WHEELCHAIR FOOT REST.

18. PROVIDE DOOR SYMBOLS ON DOORWAYS LEADING TO SANITARY FACILITIES (SEE TOILET ROOM DOOR SIGNAGE). CENTER SYMBOLS ON DOORS AT 60" HEIGHT, AND FINISH IN COLOR CONTRASTING TO

17. CENTER OF HARDWARE TO BE 30" TO 40" ABOVE FLOOR. LATCHING AND LOCKING DOOR TO BE OPERABLE WITH A SINGLE EFFORT BY LEVER OR PUSH-PULL TYPE HARDWARE.

THAT OF THE DOOR. 19. THRESHOLDS SHALL BE 1/2" HIGH MAXIMUM WITH A 2:1 DEGREE BEVELED EDGE.

20. THRESHOLD HEIGHT BETWEEN 1/4" AND 1/2" SHALL BE BEVELED AT MAZIMUM 50% SLOPE.

21. ALL EXTERIOR DOOR SHALL HAVE PERIMETER DOOR SOUND SEAL/GASKET.

22. EACH DOOR IN A MEANS OF EGRESS FROM A GROUP A, OR ASSEMBLY AREA NOT CLASSIFIED AS AN ASSEMBLY OCCUPANCY, HAVING AN OCCUPANT LOAD OF 50 OR MORE SHALL NOT BE PROVIDED WITH A LATCH OR LOCK UNLESS IT IS PANIC HARDWARE OR FIRE EXIT HARDWARE. CBC 1010.1.10 CFC 1010.1.10

**DOOR LEGEND** 

# DOOR GENERAL NOTES







| ADD        |  |
|------------|--|
| ARCHITA    |  |
| M. SIMONEC |  |
| 100 L      |  |
| -18301     |  |
| 1, 2025    |  |
| -10E       |  |

REVISIONS DESCRIPTION 90% CD SUBMITTAL ADDENDUM #2


ELEV. = 43.508'


B.M.: THE CITY OF GARDENA BENCHMARK NO. 5D-15

CITY OF GARDENA DEPARTMENT OF PUBLIC WORKS - ENGINEERING 12/15/2022 DOOR SCHEDULE 08/16/2023 **COMMUNITY AQUATICS & SENIOR CENTER** 


AP/EC 05/25/2022

DIRECTOR OF PUBLIC WORKS 当 SHT. 69 OF 176 DWG. NO. 5-2606

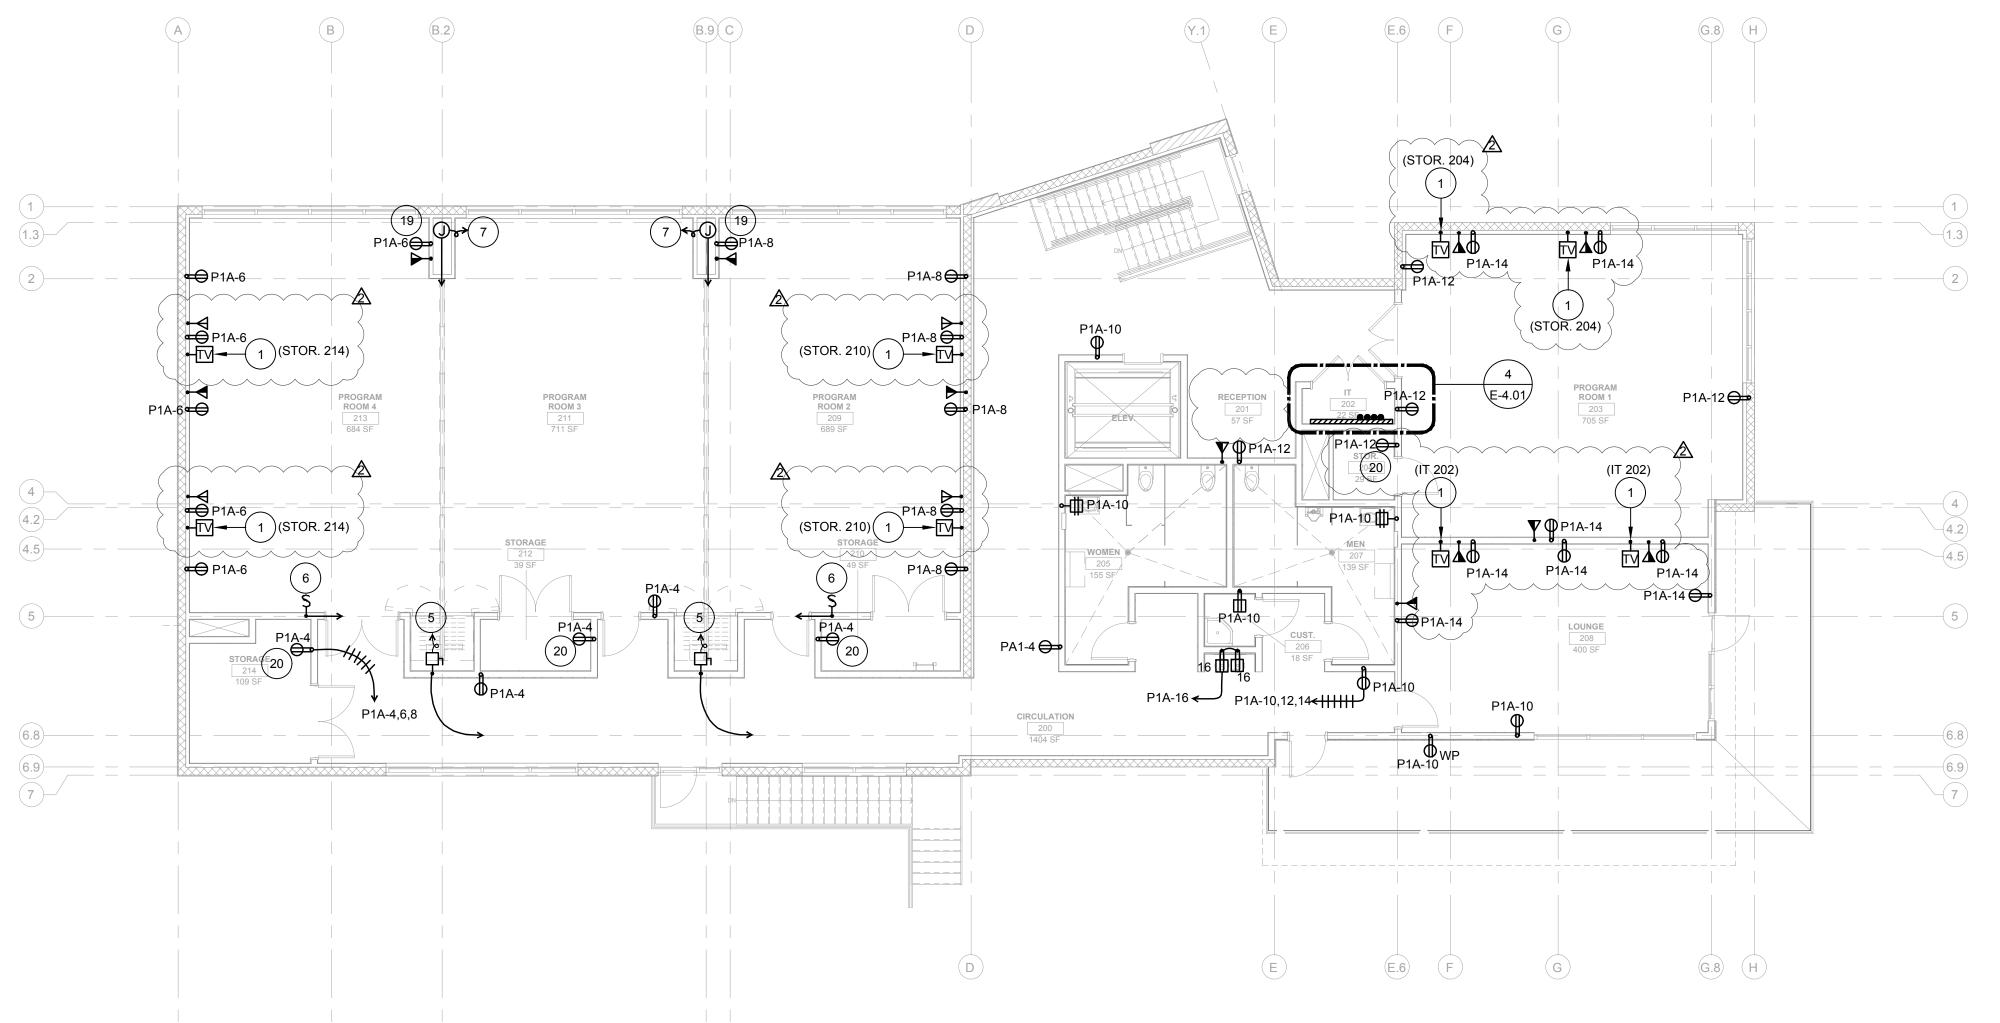

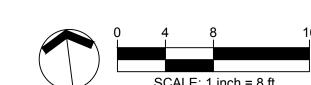

BUILDING SECOND FLOOR POWER & SIGNAL PLAN SCALE: 1/8"=1'-0" 2

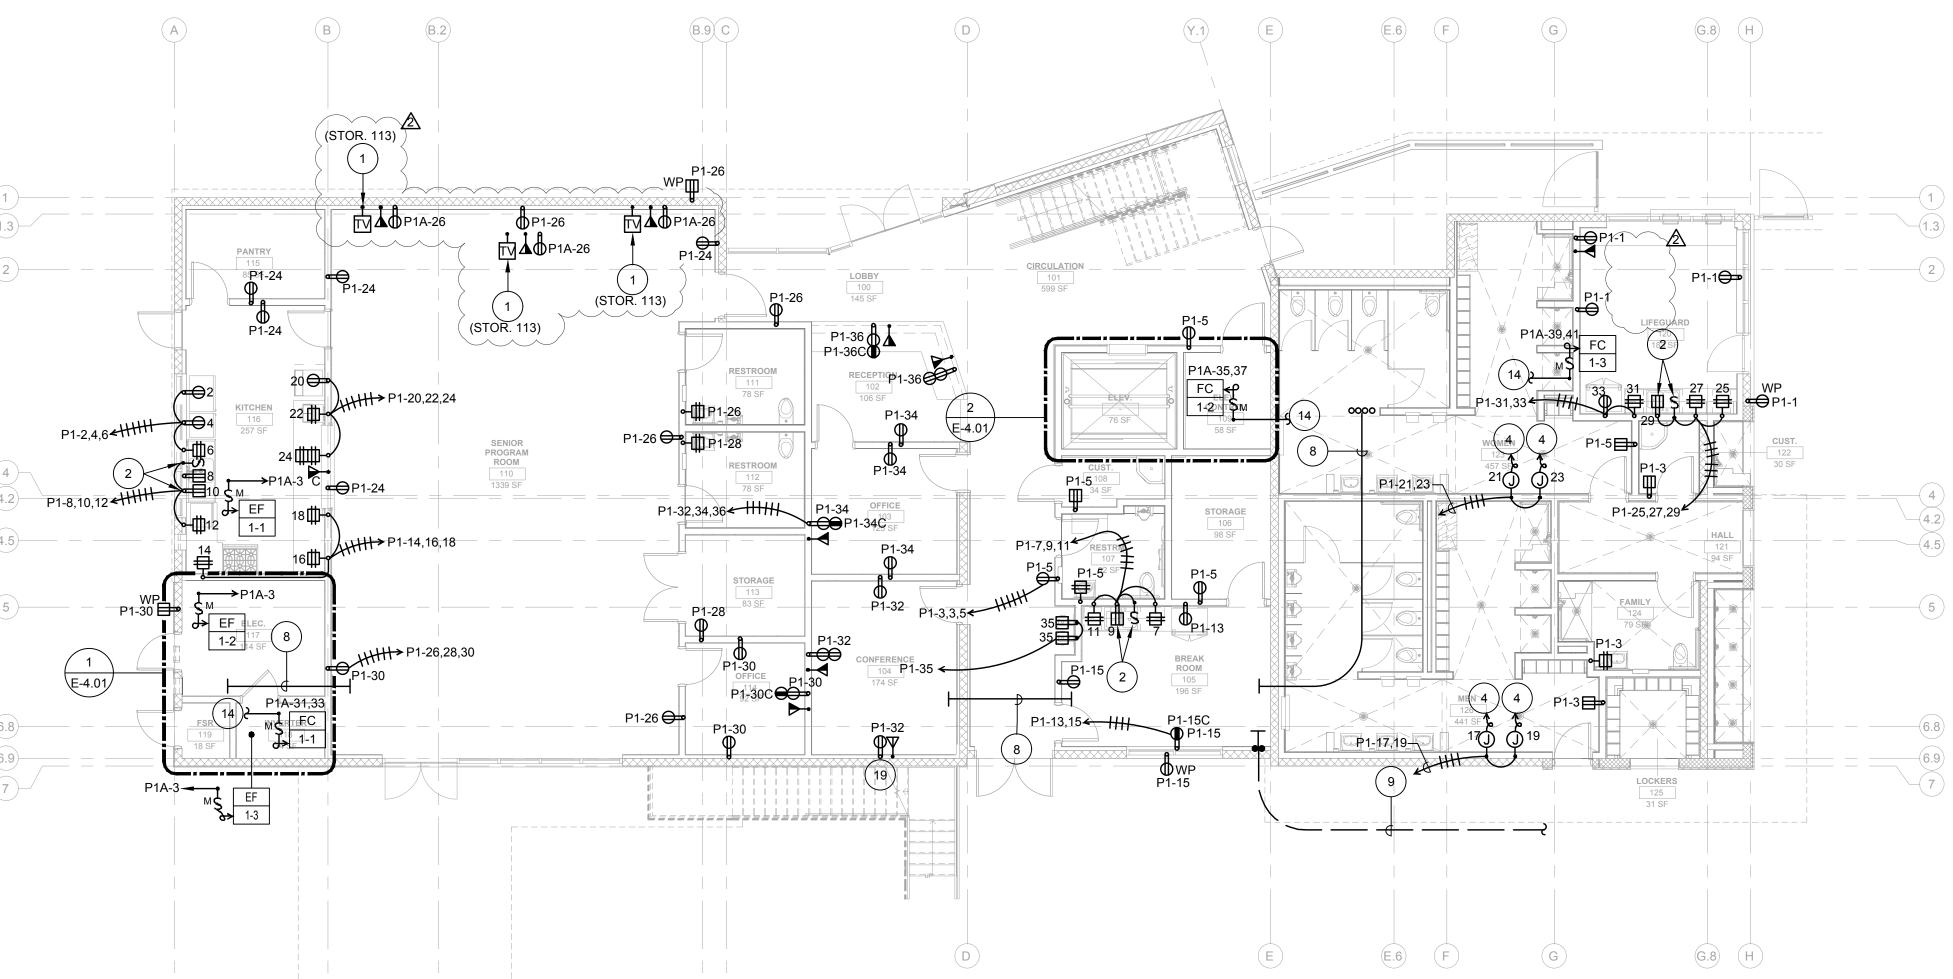

0 4 8 SCALE: 1 inch = 8 ft.

BUILDING FIRST FLOOR POWER & SIGNAL PLAN SCALE: 1/8"=1'-0" 1

PLAN NOTES

- OUTLETS FOR MONITOR . COORDINATE EXACT LOCATION & MOUNTING HEIGHT WITH ARCHITECT. REFER TO SYMBOLS LIST ON E-0.01 FOR OUTLET BOX REQUIREMENTS.
- RECEPTACLE & SWITCH FOR GARBAGE DISPOSAL. MOUNT SWITCH +6" ABOVE COUNTER SPLASH. MOUNT RECEPTACLE UNDER SINK IN CABINET SPACE.
- 3 STUB INTO ACCESSIBLE CEILING SPACE.
- CONNECT AS REQUIRED TO HAND DRYER. COORDINATE EXACT LOCATION AND REQUIREMENTS WITH ARCHITECT.
- CONNECT AS REQUIRED TO MOTORIZED PARTITION. PROVIDE WIRING AND CONNECTIONS AS REQUIRED PER MANUFACTURERS REQUIREMENTS FOR A COMPLETE AND OPERABLE PARTITION.
- 6 SWITCH FOR PARTITION CONTROL. PROVIDE WIRING AND CONNECTIONS AS REQUIRED. COORDINATE EXACT LCOATION WITH ARCHITECT.
- PARTITION SYSTEM LIMIT SWITCH. PROVIDE WIRING AND CONNECTIONS AS REQUIRED PER MANUFACTURERS REQUIREMENTS FOR A COMPLETE AND OPERABLE PARTITION. PROVIDE 3/4"C. WITH WIRING AND CONNECTIONS AS REQUIRED TO PARTITION MOTOR.
- 8 (1) 2"C. (TELECOM.) & (3) 2"C.O. (ACCESS, SECURITY & CCTV) STUB INTO ACCESSIBLE CEILING SPACE AND UP INTO 2nd FLOOR IT CLOSET.
- 9 LOW VOLTAGE CONDUIT TO POOL BUILDING. REFER TO NOTE #5 ON E-1.01 FOR QUANTITIES, SIZE AND CONTINUATION.
- 3/4"C. 3#12,1#12 GRD.
- (11) 3/4"C. 3#10, 1#10 GRD.
- (12) 3/4"C.-2#12,1#12 GRD.
- 13) TO RECEPTACLE CIRCUIT IN ROOM.
- POWERED BY OUTDOOR UNIT ON ROOF. PROVIDE 3/4"C.-2#12,1#12 GRD. TO RESPECTIVE OUTDOOR INIT ON ROOF.
- (15) CONTROLLED BY LINE VOLTAGE T-STAT. COORDINATE EXACT LOCATION &
- CONTROLLED BY LINE VOLTAGE T-STAT. COORDINATE EXACT LOCAT REQUIREMENTS WITH MECHANICAL.
- DDC CONTROL PANEL BY MECHANICAL. COORDINATE LOCATION & REQUIREMENTS WITH MECHANICAL.
- PROVIDE POWER CONNECTION TO AUTO SENSOR FOR FAUCETS AND URINALS. PROVIDE 3/4"C.-2#12, 1#12 GRD. FROM RESTROOM RECEPTACLE CIRCUIT P1-#. COORDINATE EXACT LOCATION AND REQUIREMENTS WITH PLUMBING.
- (18) RECEPTACLES FOR MICROWAVE BELOW COUNTER. COORDINATE EXACT LOCATION WITH ARCHITECT.
- 19 RECEPTACLE AVAILABLE FOR ASSITIVE LISTENING SYSTEM.
- AUDIO/VISUAL (AV) EQUIPMENT LOCATION IN STORAGE ROOM. COORDINATE EXACT LOCATION WITH OWNER.


### POWER & SIGNAL GENERAL NOTES:

- ALL WALL MOUNTED DEVICE HEIGHTS SHALL BE VERIFIED WITH ARCHITECTURAL ROOM ELEVATIONS PRIOR TO ROUGH-IN.
- 2. PENETRATIONS THROUGH FIRE RATED WALLS SHALL BE PROTECTED WITH AN APPROVED FIRE STOP SYSTEM EQUAL TO OR GREATER THAN THE RATING OF THE WALL BEING PENETRATED.
- 3. ALL DEVICES MOUNTED BACK-TO-BACK ON COMMON WALLS SHALL BE INSTALLED IN SEPARATE BOXES OFFSET 24-INCHES MINIMUM OR PROVIDED WITH PUTTY OR ANOTHER APPROVED SOUNDPROOF BACKING.
- 4. WHEN EXPOSED CEILING OR OPEN GRID CONDITIONS EXIST, CONTRACTOR SHALL PROVIDE:
- A. ALL BRANCH CIRCUITS TO BE INSTALLED IN EMT.
- B. ALL BRANCH CIRCUITS SHALL BE ROUTED PARALLEL TO BUILDING STRUCTURES AND RACKED NEATLY IN GROUPS OF MULTIPLE PATHWAYS.
- C. ALL LOW VOLTAGE CABLES SHALL BE:
  - INSTALLED IN EMT CONDUIT PATHWAYS OR
     INSTALLED NEATLY IN CABLE MANAGEMENT OPEN BASKET OR
     LADDER TYPE WIREWAY SUPPORTED INDEPENDENTLY FROM
     STRUCTURE AROVE
- ACCEPTED UNLESS APPROVED IN WRITING BY ARCHITECT/ENGINEER PRIOR TO ANY ROUGH-IN OR INSTALLATION. CONTRACTOR SHALL INCLUDE AN ALLOWANCE IN HIS BASE BID FOR THE INSTALLATION OF LOW VOLTAGE CABLES IN OPEN CEILING AS DESCRIBED.

EXPOSED LOW VOLTAGE CABLING IN OPEN TYPE CEILING APPLICATIONS INSTALLED ON D-RINGS, J-HOOKS OR SIMILAR APPARATUS WILL NOT BE

- 5. EXPOSED CABLE/CONDUCTORS INSTALLED IN A PLENUM SPACE SHALL BE LISTED FOR SUCH ENVIRONMENT AND INSTALLATION SHALL CONFORM TO NEC OR CEC WHERE ADOPTED ARTICLE 300.22(C).
- 6. ALL RECEPTACLES MOUNTED AT 5-FEET-6-INCHES OR LOWER SHALL BE TAMPER-RESISTANT TYPE, EXCEPT RECEPTACLES FOR FIXED APPLIANCES AND/OR EQUIPMENT.
- 7. COORDINATE LOCATION OF ALL OUTLETS, RECEPTACLES, AND SWITCHES WITH ARCHITECT PRIOR TO ROUGH-IN.

# CONTROLLED RECEPTACLE DETAIL

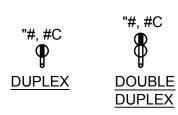


NOTE:

SUBSCRIPT / SUPERSCRIPT "#,#C" INDICATES SPLIT WIRED RECEPTACLE CONTROLLED BY ROOM'S LIGHTING CONTROLS. REFER TO LIGHTING CONTROL SYSTEM DIAGRAM ON SHEET E002A FOR ADDITIONAL REQUIREMENTS. CONTROLLED PORTION OF RECEPTACLE SHALL BE IMPRINTED "CONTROLLED". REFER TO SYMBOLS LIST FOR ADDITIONAL INFORMATION.

# BRANCH CIRCUIT GENERAL NOTES

1. FOR CLARITY, SOME BRANCH CIRCUIT CONDUIT & CONDUCTOR REQUIREMENTS HAVE NOT BEEN SHOWN ON PLANS FOR POWER BRANCH CIRCUITS. FOR POWER THROUGHOUT ALL SPACES, PROVIDE CONDUIT AND CONDUCTORS IN ACCORDANCE WITH ELECTRICAL SPECIFICATIONS. PROVIDE #12 CONDUCTORS UNLESS SPECIFICALLY NOTED OTHERWISE.

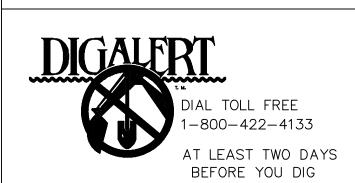

UNDERGROUND SERVICE ALERT OF SOUTHERN CALIFORNIA

SMOKE/FIRE DAMPER (SFD) GENERAL NOTES:

LOCATIONS AND QUANTITIES.

POWER FROM DAMPERS.

ELECTRICAL PLANS DO NOT SHOW ELECTRICAL REQUIREMENTS FOR SMOKE/FIRE DAMPERS (SFD). PROVIDE ALL CONDUIT, WIRE, J-BOXES, OUTLET BOXES, ETC. REQUIRED FOR A COMPLETE AND OPERABLE

PROVIDE QUANTITY OF AREA AND/OR DUCT SMOKE DETECTORS AS

POWER FOR SMOKE/FIRE DAMPERS TO BE CONTROLLED BY FIRE

ALARM RELAY OPERATED BY FIRE ALARM PANEL. CONTACT OF

RELAY TO OPEN WITH FIRE ALARM CONDITION DISCONNECTING

MECHANICAL INSTALLATION. CONNECT NO MORE THAN TEN

REFER TO MECHANICAL PLANS FOR SMOKE/FIRE DAMPER


DAMPERS PER CIRCUIT. REFER TO DETAIL 1/E-0.01.


BASIS OF BEARINGS:

BEARINGS SHOWN HEREON ARE BASED ON THE CENTERLINE OF 162 ND STREET (FORMERLY MARKET STREET) BEING N 89° 55′ 30″ E SHOWN ON TRACT NO. 10901, M.B. 254/31-32

BENCHMARK:
THE CITY OF GARDENA BENCHMARK NO. 5D-15 ELEV. = 43.508



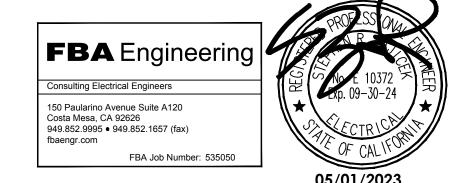

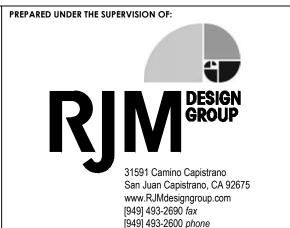



|          | NO. |  |
|----------|-----|--|
| E 10     | 1   |  |
| Ser 1 TH | 2   |  |
| 0 TE     | 3   |  |
| 2502     | 2   |  |
| -   ~    |     |  |
|          |     |  |
|          |     |  |

 R E V I S I O N S

 DESCRIPTION
 DATE
 APPROVED
 DEPAR

 90% CD SUBMITTAL
 12/15/2022
 100% CD SUBMITTAL
 05/01/2023

 FINAL SUBMITTAL
 06/30/2023
 COA

 ADDENDUM 2
 08/16/2023

CITY OF GARDENA
DEPARTMENT OF PUBLIC WORKS - ENGINEERING
BUILDING POWER & SIGNAL PLANS

COMMUNITY AQUATICS & SENIOR CENTER E-3.01