

PERFORATED UNDERGROUND INFILTRATION SYSTEM

BEFORE YOU DIG UNDERGROUND SERVICE ALERT OF SOUTHERN CALIFORNIA

BASIS OF BEARINGS:

BEARINGS SHOWN HEREON ARE BASED ON THE CENTERLINE OF 162 ND STREET (FORMERLY MARKET STREET) BEING N 89° 55' 30" E SHOWN ON TRACT NO. 10901, M.B. 254/31-32

BENCHMARK:

THE CITY OF GARDENA BENCHMARK NO. 5D-15 ELEV. = 43.508











	REVISIONS					
A. D.	NO.	DESCRIPTION	DATE	APPROVED		
APE AD	1	90% CD SUBMITTAL	12/15/2022			
ZENSE ZECT TE	2	ADDENDUM #2	08/16/2023			
	3	ADDENDUM # 3	08/28/2023			
2502 CT						
<u>023</u> Date ###						
23						
L I FOR						
	B.M.:	THE CITY OF GARDENA BE	NCHMARK N	IO. 5D-15		


ELEV. = 43.508'

N.T.S. CITY OF GARDENA REVISIONS DEPARTMENT OF PUBLIC WORKS - ENGINEERING DATE APPROVED DESCRIPTION 90% CD SUBMITTAL 12/15/2022 **DETAIL SHEET** ADDENDUM #2 08/16/2023 **COMMUNITY AQUATICS & SENIOR CENTER** ADDENDUM # 3 C-0.03

CHECKED BY

SCALE:

OF 176 DWG. NO. 5-2606

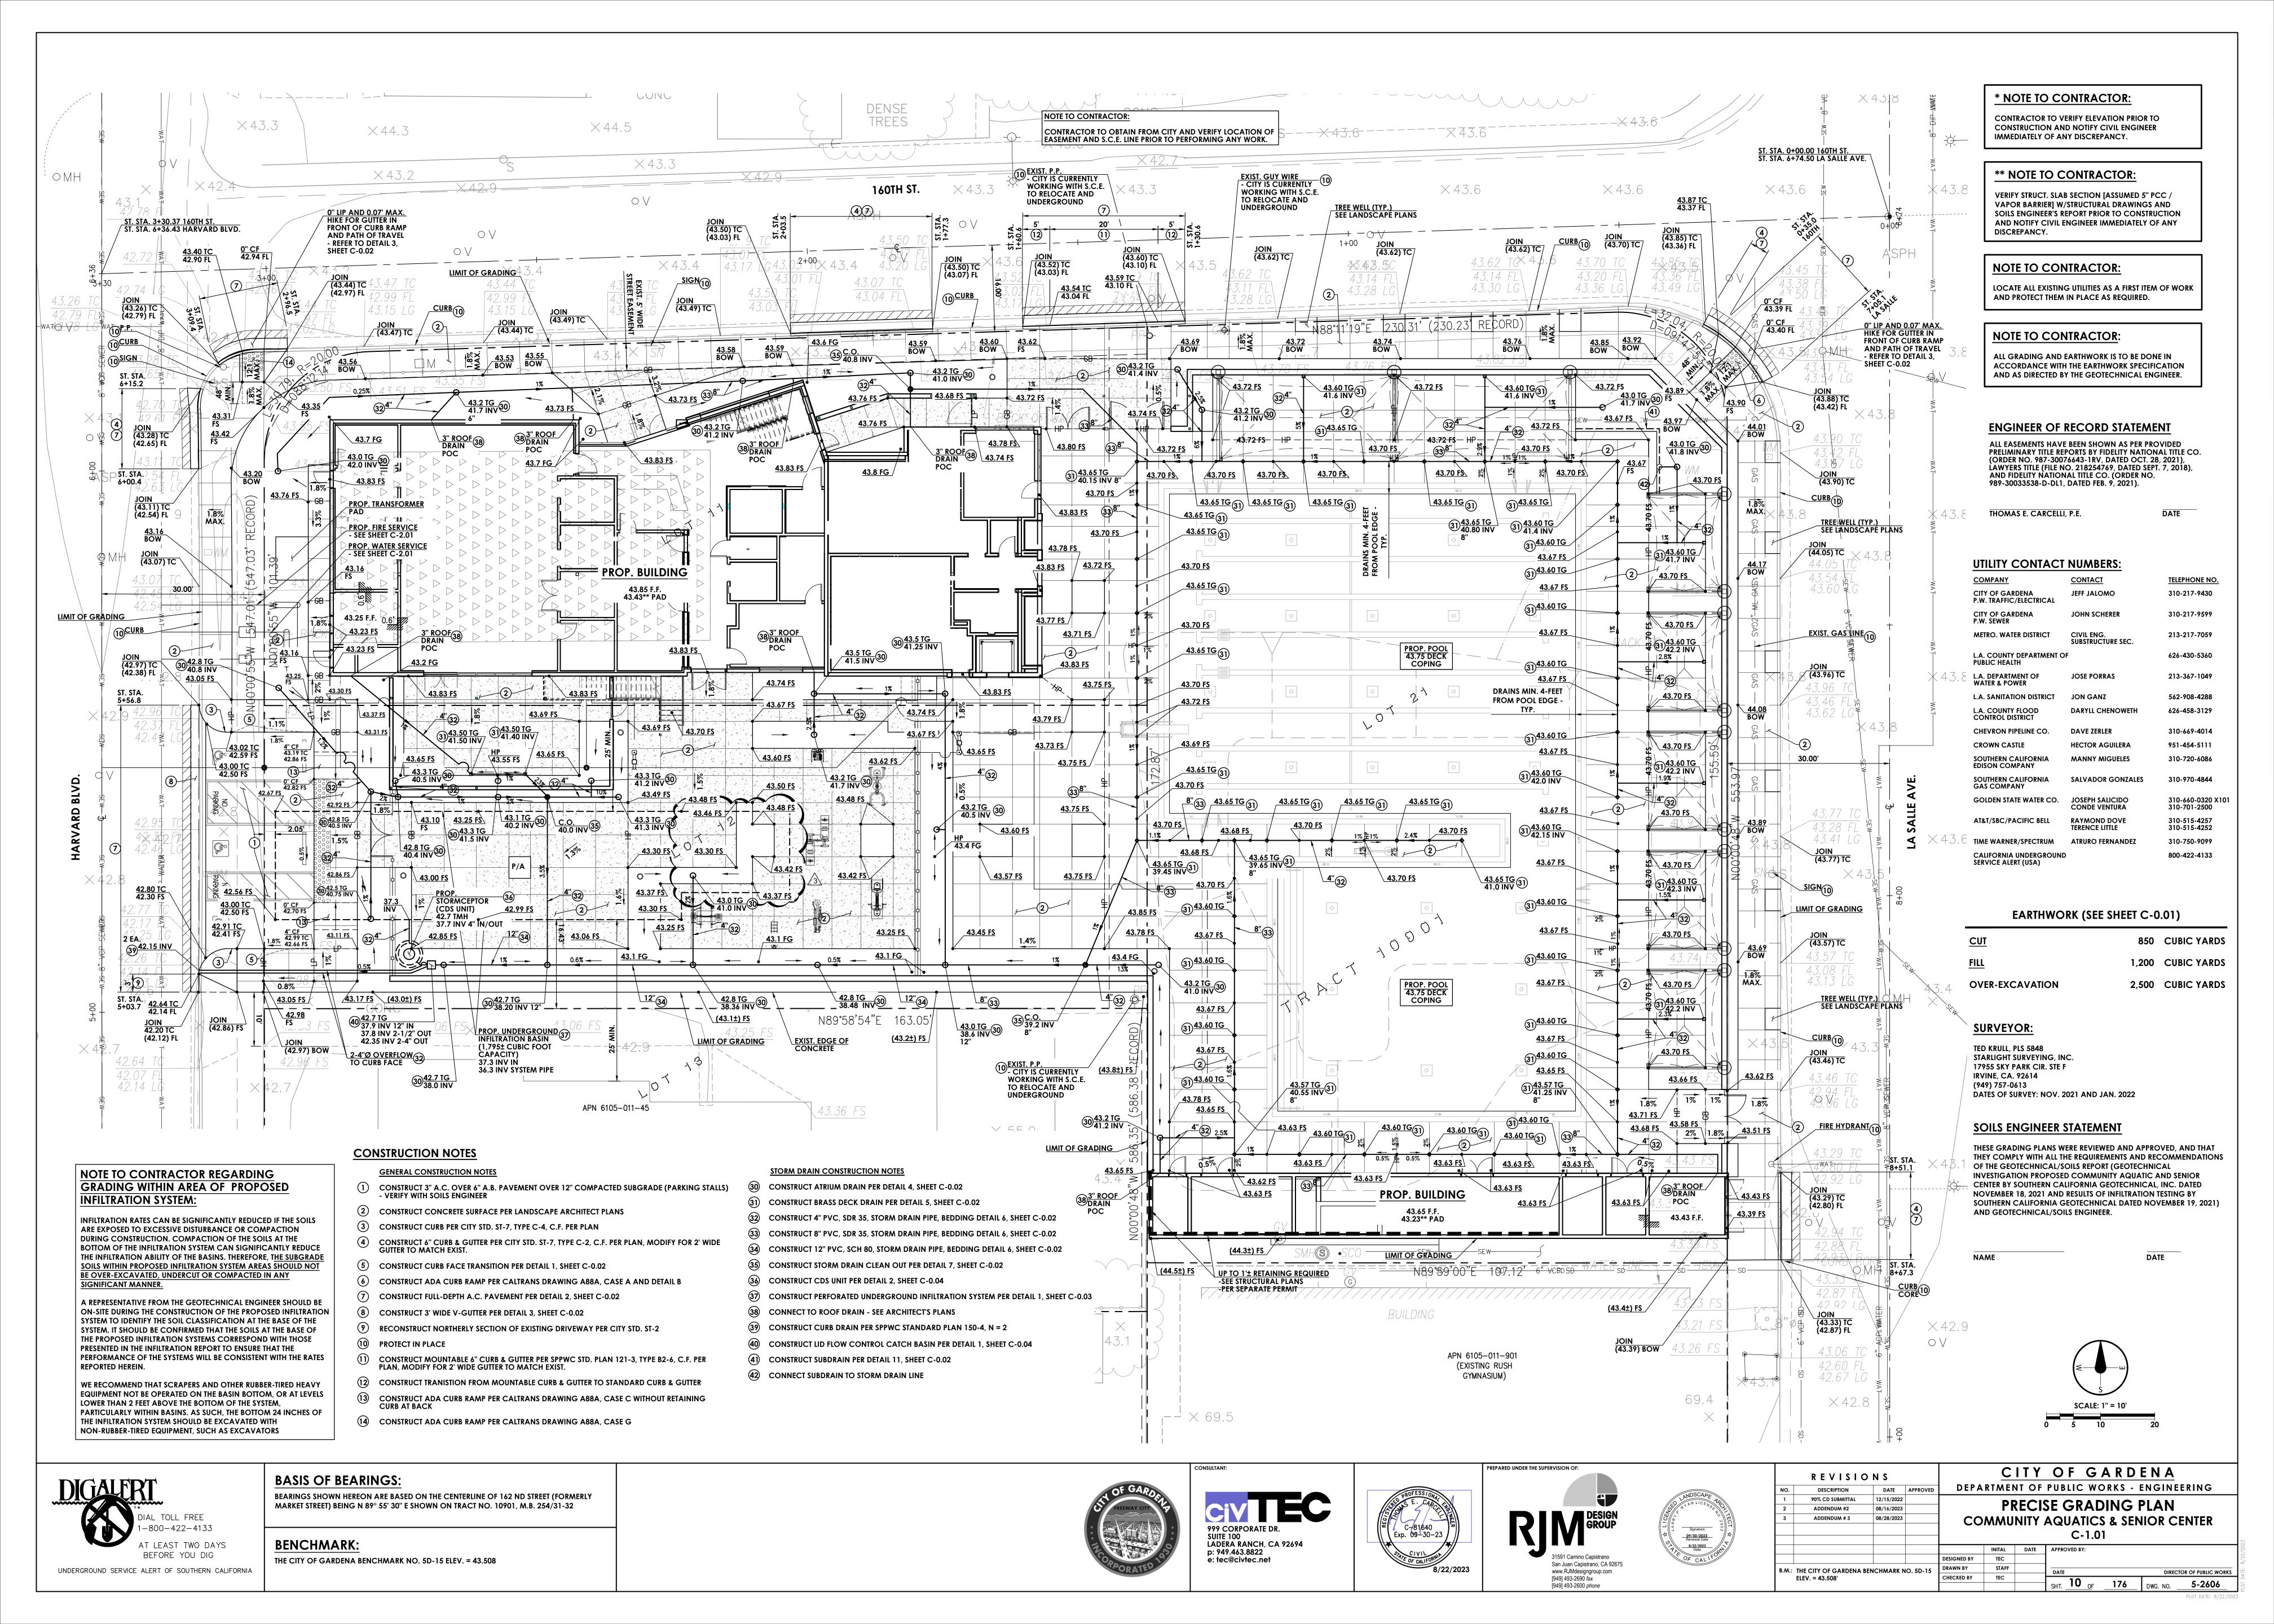

CODE ANALYSIS SEE SHEET GEN-2 FOR COMPLETE CODE ANALYSIS PROJECT SUMMARY CITY OF GARDENA **BUILDING AND SAFETY DEPARTMENT** 1700 W 162ND STREET GARDENA, CA 90247 P: 310.217.9530 **LOCAL FIRE AUTHORITY** LOS ANGELES COUNTY FIRE DEPARTMENT 200 NORTH MAIN STREET, 16TH FLOOR LOS ANGELES, CA 90012 P: 213.978.3800 P: 949.852.9995 **GOVERNING AGENCIES** INCLUDING, BUT NOT LIMITED TO, THE FOLLOWING: AMERICANS WITH DISABILITIES ACT (ADA) ACCESSIBILITY GUIDELINES FOR BUILDINGS AND FACILITIES (ADAAG) STATE OF CALIFORNIA PARTIAL LIST OF APPLICABLE CODES AS OF JAN 1, 2020 2019 BUILDING STANDARDS ADMINISTRATIVE CODE CALIFORNIA CODE OF REGULATIONS (CCR) PART 1, TITLE 24 C.C.R. 2019 CALIFORNIA BUILDING CODE (CBC) CALIFORNIA CODE OF REGULATIONS (CCR) TITLE 24, PART 2 (2018 INTERNATIONAL BUILDING CODE WITH THE INTERNATIONAL CODE COUNCIL WITH CALIFORNIA AMENDMENTS) 2019 CALIFORNIA ELECTRICAL CODE (CEC) CALIFORNIA CODE OF REGULATIONS (CCR) TITLE 24, PART 3 (2018 NATIONAL ELECTRICAL CODE OF THE NATIONAL FIRE PROTECTION ASSOCIATION, NFPA) 2019 CALIFORNIA MECHANICAL CODE CALIFORNIA CODE OF REGULATIONS (CCR) TITLE 24, PART 4 W 158TH ST (2018 UNIFORM MECHANICAL CODE OF THE INTERNATIONAL ASSOCIATION V 166TH ST-OF PLUMBING AND MECHANICAL OFFICIALS, IAPMO) 2019 CALIFORNIA PLUMBING CODE W 166TH ST CALIFORNIA CODE OF REGULATIONS (CCR) TITLE 24, PART 5 W 161ST ST (2018 UNIFORM PLUMBING CODE OF THE INTERNATIONAL ASSOCIATION OF THE PLUMBING AND MECHANICAL OFFICIALS, IAPMO) 2019 CALIFORNIA ENERGY CODE CALIFORNIA CODE OF REGULATIONS (CCR) TITLE 24, PART 6 PROJECT -**2019 CALIFORNIA FIRE CODE** SITE W 164TH ST CALIFORNIA CODE OF REGULATIONS (CCR) TITLE 24, PART 9 W GARDENA BLVD (2018 INTERNATIONAL FIRE CODE OF THE INTERNATIONAL CODE COUNCIL) W GARDENA BLVD 2019 CALIFORNIA GREEN BUILDING STANDARDS CODE (CAL GREEN CODE) CALIFORNIA CODE OF REGULATIONS (CCR) TITLE 24, PART 11 166TH ST 2019 CALIFORNIA REFERENCED STANDARDS CODE CALIFORNIA CODE OF REGULATIONS (CCR) TITLE 24, PART 12 PUBLIC SAFETY, STATE FIRE MARSHAL REGULATIONS CALIFORNIA CODE OF REGULATIONS (CCR) TITLE 19 PARTIAL LIST OF APPLICABLE STANDARDS: W 170TH ST 2019 BUILDING CODE (FOR SFM) REFERENCED STANDARDS **CHAPTER 35** NFPA 17 NFPA 17A NFPA 72 NFPA 80 UL 464 UL 521

VICINITY MAP

PROJECT ADDRESS

GARDENA, CA 90247

1654 W 166TH STREE

EQUIPMENT BUILDING

PROJECT DESCRIPTION:

NEW SENIOR CENTER AND AQUATICS BUILDING WITH NEW POOL AND POOL

CITY OF GARDENA 1700 W 162ND STREET

GARDENA, CA 90247 CONTACT: ALLAN RIGG, PE AICP P: 310.217.9530 <u>ARCHITECT</u>

SVA ARCHITECTS ALFATECH 6 HUTTON CENTRE DRIVE, SUITE 1150 510 WEST 6TH STREET, SUITE 1105 SANTA ANA,CA 92707 LOS SNGELES, CA 90014 CONTACT: PROJECT MANAGER CONTACT: NICK KOURASSIS P: 949.809.3380 P: 213.212.9860

PROJECT DIRECTORY

AUTOMATIC SPRINKLER SYSTEM

WET CHEMICAL SYSTEMS

SYSTEMS

NATIONAL FIRE ALARM CODE

AUDIBLE SIGNAL APPLIANCES

DRY CHEMICAL EXTINGUISHING SYSTEMS

FIRE DOORS AND OTHER OPENING PROTECTIVES

HEAT DETECTORS FOR FIRE PROTECTION SIGNAL

CLEAN AGENT FIRE EXTINGUISHING SYSTEMS

APPLICABLE CODES

MECHANICAL

<u>PLUMBING</u>

ALFATECH

P: 213.212.9860

510 WEST 6TH STREET, SUITE 1105

2016 EDITION

2016 EDITION

2018 EDITION

2016 EDITION

1999 EDITION

LOS SNGELES, CA 90014

CONTACT: MARCIA MCKONE

<u>STRUCTURAL</u> VCA ENGINEERS INC 1041 S GARFIELD AVE #210 ALHAMBRA, CA 91801 **CONTACT: ALEX QUINONEZ** P: 323.729.6098

ELECTRICAL FBA ENGINEERS 150 PAULARINO AVENUE SUITE A120 COSTA MESA, CA 92626 CONTACT: STEPHEN ZAJICEK

STATEMENT OF GENERAL CONFORMANCE THE DRAWINGS OR SHEETS LISTED IN THE INDEX ON THIS SHEET HAVE BEEN PREPARED BY OTHER DESIGN PROFESSIONALS OR CONSULTANTS WHO ARE LICENSED AND/OR AUTHORIZED TO PREPARE SUCH DRAWINGS IN THIS STATE. IT HAD BEEN EXAMINED BY ME FOR:

DESIGN INTENT AND APPEARS TO MEET THE APPROPRIATE REQUIREMENTS OF TITLE 24, CALIFORNIA CODE OF REGULATIONS AND THE PROJECT SPECIFICATIONS PREPARED BY ME

COORDINATION WITH MY PLANS AND SPECIFICATIONS AND IS ACCEPTABLE

FOR INCORPORATION INTO THE CONSTRUCTION OF THE PROJECT.

THIS STATEMENT OF GENERAL CONFORMANCE "SHALL" NOT BE CONSTRUED AS RELIEVING ME OF MY RIGHTS, DUTIES AND RESPONSIBILITIES UNDER SECTION 4-336, 4-341 AND 4-344 OF TITLE 24, PART 1 (TITLE 24, PART 1 SECTION 4-317) (B))

I CERTIFY THAT ALL DRAWINGS OR SHEETS LISTED IN THE INDEX ON THIS SHEET (CIVIL, STRUCTURAL, MECHANICAL, PLUMBING, ELECTRICAL, FIRE PROTECTION AND THEATRICAL) ARE IN GENERAL CONFORMANCE AND HAVE BEEN COORDINATED.

GENERAL CONFORMANCE STATEMENT

THIS PROJECT SHALL COMPLY WITH ALL FEDERAL. STATE AND LOCAL CODES SVA ARCHITECTS IS THE DESIGNATED ARCHITECT OF RECORD AS REQUIRED BY THE STATE OF CALIFORNIA. THE ARCHITECT OF RECORD SHALL REVIEW SUBMITTALS AND COORDINATE SUBMITTALS AND DEFERRED SUBMITTALS THROUGH THE CITY OF GARDENA. DEFERRED SUBMITTALS SHALL NOT BE INSTALLED UNTIL THEIR DESIGN AND SUBMITTAL DOCUMENTS HAVE BEEN

APPROVED BY THE CITY OF GARDENA.

THE BUILDING OFFICIAL SHALL BE NOTIFIED IN WRITING BY THE OWNER IF THE ARCHITECT OF RECORD IS CHANGED OR IS UNABLE TO CONTINUE TO PERFORM THE DUTIES. THE OWNER SHALL DESIGNATE A SUBSTITUTE ARCHITECT OR ENGINEER OF RECORD WHO SHALL PERFORM ALL OF THE DUTIES REQUIRED OF THE ORIGINAL ARCHITECT OF RECORD.

REVIEW AND COMMENT ON SUBMITTALS AND DEFERRED SUBMITTALS SHALL NOT RELIEVE THE AUTHOR OF THE DOCUMENTS OR THE CONTRACTOR FROM COMPLIANCE WITH ALL APPLICABLE CODES AND THE REQUIREMENTS OF THE DRAWINGS AND SPECIFICATIONS. THE REVIEW IS ONLY FOR GENERAL CONFORMANCE WITH THE DESIGN CONCEPT OF THE PROJECT AND GENERAL COMPLIANCE WITH INFORMATION GIVEN IN THE CONTRACT DOCUMENTS. THE CONTRACTOR IS RESPONSIBLE FOR CONFIRMING AND CORRELATING ALL QUANTITIES AND DIMENSIONS, SELECTING FABRICATION PROCESSES AND TECHNIQUES OF CONSTRUCTION, COORDINATING HIS WORK WITH THAT OF OTHER TRADES, AND PERFORMING HIS WORK IN A SAFE AND SATISFACTORY MANNER.

ARCHITECT OF RECORD

THE FOLLOWING ITEMS ARE DESIGN-BUILD SYSTEMS AND WILL BE A DEFERRED SUBMITTAL BY THE CONTRACTOR AT A LATER DATE. THE CONTRACTOR SHALL BE RESPONSIBLE FOR ENGINEERING AND CALCULATIONS FOR APPLICABLE ITEMS. THE CONTRACTOR SHALL RETAIN THE SERVICES OF A CIVIL OR STRUCTURAL ENGINEER WHO SHALL BE RESPONSIBLE FOR THE DESIGN. THE CONTRACTOR SHALL SUBMIT CALCULATIONS AND SHOP DRAWINGS TO THE ARCHITECT OF RECORD, WHO SHALL REVIEW THEM WITH NOTATION INDICATING THAT THE DEFERRED SUBMITTAL DOCUMENTS HAVE BEEN FOUND TO BE IN GENERAL CONFORMANCE WITH THE DESIGN OF THE BUILDING. THE SUBMITTAL ITEMS SHALL NOT BE INSTALLED UNTIL THEIR DESIGN AND SUBMITTAL DOCUMENTS HAVE BEEN APPROVED BY THE GOVERNING AGENCY. THE CONTRACTOR IS RESPONSIBLE FOR SUBMITTAL OF THE DEFERRED SUBMITTAL DOCUMENTS.

1. ELEVATOR GUIDE RAILS (MIN. 15 LB GUIDE RAILS) & SUPPORT BRACKETS 2. FIRE SPRINKLER SYSTEM 3. FIRE ALARM SYSTEM 4. ROOF ACCESS LADDERS

DEFERRED SUBMITTALS

1. THESE DOCUMENTS AND THE IDEAS AND DESIGNS INCORPORATED HEREIN, AS AN INSTRUMENT OF PROFESSIONAL SERVICE, ARE THE PROPERTY OF SVA ARCHITECTS, INC., AND ARE NOT TO BE USED, IN WHOLE OR IN PART FOR ANOTHER PROJECT WITHOUT THE WRITTEN AUTHORIZATION OF SVA ARCHITECTS, INC.

2. THE WORK SHOWN ON THESE DRAWINGS AS EXISTING CONDITIONS WAS PREPARED FROM INFORMATION FURNISHED BY THE OWNER. WHILE THIS INFORMATION IS BELIEVED TO BE RELIABLE, SVA ARCHITECTS,INC.. IS NOT RESPONSIBLE FOR THE ACCURACY OR ADEQUACY OF ANY WORK SHOWN AS EXISTING NOR IS SVA ARCHITETS, INC. RESPONSIBLE FOR ANY ERRORS OR OMISSIONS WHICH MAY HAVE BEEN INCORPORATED INTO THESE DRAWINGS AS A RESULT.

3. EACH BIDDER SHALL POSSESS AT THE TIME OF BID A CLASS B OR THE APPROPRIATE CLASS C CONTRACTOR'S LICENSE PURSUANT TO PUBLIC CONTRACT CODE SECTION 3300 AND BUSINESS AND PROFESSIONS CODE SECTION 7028.15. THE SUCCESSFUL BIDDER MUST MAINTAIN THE LICENSE THROUGHOUT THE DURATION OF THIS CONTRACT

4. CONTRACTOR IS RESPONSIBLE FOR FIRE SAFETY DURING CONSTRUCTION AND THE DURATION OF THIS CONTRACT PER 2013 CALIFORNIA FIRE CODE, CHAPTER 33.

ACCORDANCE WITH THE REQUIREMENTS OF TITLE 24 OF THE CALIFORNIA CODE OF REGULATIONS WILL BE ASSIGNED TO THE WORK. THE INSPECTORS DUTIES ARE SPECIFICALLY DEFINED IN SECTION 4-342 OF SAID TITLE 24,

5. INSPECTOR OF RECORD REQUIREMENTS: A. ONE OR MORE INSPECTORS EMPLOYED BY THE OWNER IN

6. ALL CONSTRUCTION SHALL BE IN ACCORDANCE WITH THE REQUIREMENTS OF THE APPLICABLE CODES. ALL ENGINEERING SHALL COMFORM WITH ALL APPLICABLE MUNICIPAL, STATE AND FEDERAL REGULATIONS HAVING JURISDICTION INCLUDING ACCESSIBILITY STANDARDS AND ADA REQUIREMENTS.

7. GRADING PLANS, DRAINAGE IMPRPOVEMENTS, ROAD AND ACCESS REQUIREMENTS AND ENVIROMENTAL HEALTH CONCIDERATIONS SHALL COMPLY WITH ALL LOCAL ORDINANCES.

8. DRINKING WATER SHALL COMPLY WITH ALL LOCAL HEALTH DEPARTMENT REQUIREMENTS.

9. DO NOT SCALE THE DRAWINGS. THE DRAWINGS ARE NOT NECESSARILY TO SCALE. THE CONTRACTOR SHALL VERIFY ALL CONDITIONS AND DIMENSIONS IN THE FIELD PRIOR TO BIDDING AND START OF CONSTRUCTION. IF DISCREPANCIES ARE FOUND, THE ARCHITECT SHALL BE NOTIFIED FOR CLARIFICATION BEFORE COMMENCING WORK.

10. ALL DIMENSIONS ARE TO FACE OF CONCRETE, FACE OF MASONRY UNITS, CENTERLINE OF COLUMNS AND BEAMS OR FACE OF STUDS, UNLESS OTHERWISE NOTED. FINISH FLOOR ELEVATIONS ARE TO TOP OF CONCRETE SLAB OR TOP OF INTERIOR PAVING UNLESS NOTED OTHERWISE. CEILING HEIGHT DIMENSIONS ARE TO FINISHED SURFACES UNLESS NOTED OTHERWISE.

11. THE CIVIL, STRUCTURAL, MECHANICAL, PLUMBING, AND ELECTRICAL DRAWINGS ARE SUPPLEMENTAL TO THE ARCHITECTURAL DRAWINGS. IT SHALL BE THE RESPONSIBILITY OF THE CONTRACTOR TO CHECK WITH THE ARCHITECTURAL DRAWINGS BEFORE PROCEEDING WITH INSTALLATION OF CIVIL. STRUCTURAL MECHANICAL PLUMBING, AND ELECTRICAL WORK. SHOULD THERE BE ANY DISCREPANCIES BETWEEN THE ARCHITECT'S AND THE NSULTING ENGINEER'S DRAWINGS AND SPECIFICATIONS THAT WOULD CAUSE A CONFLICT. IT SHALL BE BROUGH TO THE ARCHITECTS ATTENTION FOR CLARIFICATION PRIOR TO INSTALLATION OF SAID WORK, ANY WORK INSTALLED IN CONFLICT WITH THE ARCHITECTURAL DRAWINGS SHALL BE CORRECTED BY THE CONTRACTOR AT HIS EXPENSE AND AT NO ADDITIONAL COST TO THE OWNER OR ARCHITECT.

12. ALL SYMBOLS AND ABBREVIATIONS USED ON THE DRAWINGS ARE CONSIDERED TO BE CONSTRUCTION STANDARDS. IF THE CONTRACTOR HAS QUESTIONS REGARDING ABBREVIATIONS OR THEIR EXACT MEANING. THE ARCHITECT SHALL BE NOTIFIED FOR CLARIFICATION.

13. DETAILS MARKED "TYPICAL" SHALL APPLY IN ALL SIMILAR CASES UNLESS SPECIFICALLY INDICATED OTHERWISE. 14. THERE SHALL BE NO TRENCHES OR EXCAVATIONS 5' OR MORE IN DEPTH INTO WHICH A PERSON IS REQUIRED TO DECEND UNLESS A PERMIT IS OBTAINED FROM THE STATE OF CALIFORNIA DIVISION OF INDUSTRIAL SAFETY PRIOR TO THE ISSUANCE OF A BUILDING OR GRADING PERMIT.

15. THE CONSTRUCTION OR DEMOLITION OF ANY BUILDING, STRUCTURE, SCAFFOLDING OR FALSEWORK MORE THAN 3 STORIES OR 36' IN HEIGHT REQUIRES A PERMIT FROM THE STATE OF CALIFORNIA DIVISION OF INDUSTRIAL SAFETY PRIOR TO THE ISSUANCE OF A BUILDING PERMIT.

16. ALL CONSTRUCTION SHALL PERFORMED IN ACCORDANCE WITH THE STATE CONSTRUCTION SAFETY ORDERS ENFORCED BY THE STATE DIVISION OF INDUSTRIAL SAFETY.

17. DIMENSIONS AND CONDITIONS AT THE JOB SITE SHALL BE VERIFIED BY ALL CONTRACTORS. IT IS THE RESPONSIBILITY OF THE CONTRACTOR TO EXAMINE THE EXISTING CONDITIONS PRIOR TO SUBMITTING BIDS TO THE OWNER SINCE PROPOSALS MUST TAKE INTO CONSIDERATION ALL SUCH CONDITIONS THAT MAY AFFECT THE WORK. DISCREPANCIES IN THE DRAWINGS OR BETWEEN THE DRAWINGS AND ACTUAL FIELD CONDITION SHALL BE REPORTED TO THE ARCHITECT, REVISED DRAWINGS OR INSTRUCTIONS SHALL BE ISSUED BY THE OWNER PRIOR TO THE INSTALLATION OF ANY WORK.

18. NO CHANGES ARE TO BE MADE ON THESE PLANS WITHOUT THE KNOWLEDGE OR CONSENT OF THE ARCHITECT/ENGINEER WHOSE SIGNATURE APPEARS HEREON.

19. LOCATIONS OF ALL UTILITIES SHOWN ARE APPROXIMATE AND CONTRACTOR SHALL EXERCISE EXTREME CAUTION IN EXCAVATING AND TRENCHING ON THIS SITE TO AVOID INTERCEPTING EXISTING PIPING OR CONDUITS. IT SHALL BE THE RESPONSIBILITY OF THE CONTRACTOR TO LOCATE ALL EXISTING UTILITIES WHETHER SHOWN HEREON OR NOT AND TO PROTECT THEM FROM DAMAGE. THE ARCHITECT IS NOT RESPONSIBLE FOR THE LOCATION OF UNDERGROUND UTILITIES OR STRUCTURES WHETHER OR NOT SHOWN OR DETAILED AND INSTALLED BY ANY OTHER CONTRACT. THE CONTRACTOR SHALL IMMEDIATELY NOTIFY THE ARCHITECT SHOULD ANY UNIDENTIFIED CONDITIONS BE DISCOVERED. THE CONTRACTOR SHALL BEAR ALL EXPENSE OF REPAIR OR REPLACEMENT OF UTILITIES OR OTHER PROPERTY DAMAGED BY OPERATIONS IN CONJUNCTION WITH THE PROSECUTION OF THIS WORK.

FIRE SAFETY

1. FIRE SAFETY DURING CONSTRUCTION AND THE DURATION OF THIS CONTRACT: GENERAL: FIRE SAFETY DURING CONSTRUCTION SHALL COMPLY WITH 2019 CALIFORNIA

ACCESS ROADS: FIRE DEPARTMENT ACCESS ROADS SHALL BE ESTABLISHED AND MAINTAINED IN ACCORDANCE WITH SECTION 1410.

WATER SUPPLY: WATER MAINS AND HYDRANTS SHALL BE OPERATIONAL IN ACCORDANCE WITH SECTION 1412.

FIRE CODE TITLE 24, PART 9, CHAPTER 33.

BUILDING ACCESS: ACCESS TO BUILDINGS FOR THE PURPOSE OF FIREFIGHTING SHALL BE PROVIDED. CONSTRUCTION MATERIAL SHALL NOT BLOCK ACCESS TO BUILDINGS, HYDRANTS OR FIRE APPLIANCES.

FIRE WATCH: MAINTAIN FIRE WATCH WHEN REQUIRED BY THE BUILDING OFFICIAL AND/OR WHEN EXISTING FIRE PROTECTION SYSTEMS ARE SHUT DOWN FOR ALTERATIONS. FIRE WATCH SHALL REMAIN IN EFFECT UNTIL EXISTING FIRE PROTECTION SYSTEMS ARE RETURNED TO SERVICE OR AS ALLOWED BY THE BUILDING OFFICIAL.

2. CONTRACTOR REQUIRED TO COMPLY WITH CURRENT CODE AND CITY STANDARDS.

3. CONTRACTOR IS RESPONSIBLE FOR FIRE SAFETY DURING CONSTRUCTION AND THE DURATION OF THIS CONTRACT PER 2019 CALIFORNIA FIRE CODE, CHAPTER 33.

PLAN CHECK NOTES

1. THE CITY OF GARDENA BUILDING DEVISION ENFORCES THE CALIFORNIA BUILDING CODE (CBC) TITLE 24 CHAPTER 11B FOR DISABLED ACCESS COMPLIANCE AND DOES NOT REVIEW OR APPROVE PLANS FOR COMPLIANCE WITH THE AMERICANS WITH DISABILITIES ACT (ADA).

GENERAL NOTES

ANTA ANA, CA 92707

HUTTON CENTRE DR, SUITE 1150

ARCHITECTURAL

PROJECT INFORMATION & SHEET INDEX

GEN-2 CODE ANALYSIS & EXITING PLAN GEN-3 **GENERAL NOTES** PROJECT SIGNAGE

GEN-5 ACCESSIBILITY DETAILS SITE PLAN FIRE MASTER PLAN SLAB PLAN

FIRST FLOOR PLAN SECOND FLOOR PLAN

ROOF PLAN FIRST FLOOR RCP

SECOND FLOOR RCP **ELEVATIONS BUILDING SECTIONS**

WALL SECTIONS A32.2 WALL SECTIONS WALL SECTIONS A32.3 **ASSEMBLIES**

> **ASSEMBLIES** POOL BUILDING PLANS, ELEVATIONS, AND SECTIONS

POOL BUILDING DETAILS ENLARGED LOCKER ROOM PLANS AND ELEVATIONS

ENLARGED PLANS AND ELEVATIONS

INTERIOR ELEVATIONS INTERIOR STAIR PLANS AND SECTIONS

EXTERIOR STAIR PLANS AND SECTIONS TRELLIS PLANS AND SECTIONS FIRST FLOOR INTERIOR FINISH SCHEDULE

SECOND FLOOR INTERIOR FINISH SCHEDULE

DOOR SCHEDULE

STOREFRONT ELEVATIONS

WALL TYPES

DETAILS WALL ASSEMBLIES

DETAILS CEILING **DETAILS CEILING**

DETAILS ROOF DETAILS ROOF

DETAILS DOOR

WINDOW AND WALL ASSEMBLY DETAILS

STAIR AND RAILING DETAILS

TRELLIS, FENCE AND MISC. DETAILS

MISCELLANEOUS DETAILS

DETAILS CASEWORK & MISC.

TILE DETAILS

SHEET INDEX

949.809.3380 WWW.SVA-ARCHITECTS.COM

REVISIONS DESCRIPTION 90% CD SUBMITTAL 12/15/2022 08/16/2023 ADDENDUM #3 08/28/2023


B.M.: THE CITY OF GARDENA BENCHMARK NO. 5D-15


ELEV. = 43.508'


CITY OF GARDENA DEPARTMENT OF PUBLIC WORKS - ENGINEERING PROJECT INFORMATION & SHEET INDEX **COMMUNITY AQUATICS & SENIOR CENTER**


DIRECTOR OF PUBLIC WORKS SHT. 39 OF 176 DWG. NO. 5-2606


VA ARCHITECTS INC. AND IS FURNISHED IN CONFIDENCE OR THE LIMITED PURPOSE OF EVALUATION, BIDDING OR REVIEW. THIS DOCUMENT OR ITS CONTENTS MAY NOT BE USED FOR ANY OTHER PURPOSE AND MAY NOT BE REPRODUCED OR DISCLOSED TO OTHERS WITHOUT THE PRIOR WRITTEN CONSENT OF SVA ARCHITECTS INC. ALL ARCHITECTS RIGHTS RESERVED, © COPYRIGHT 2018.

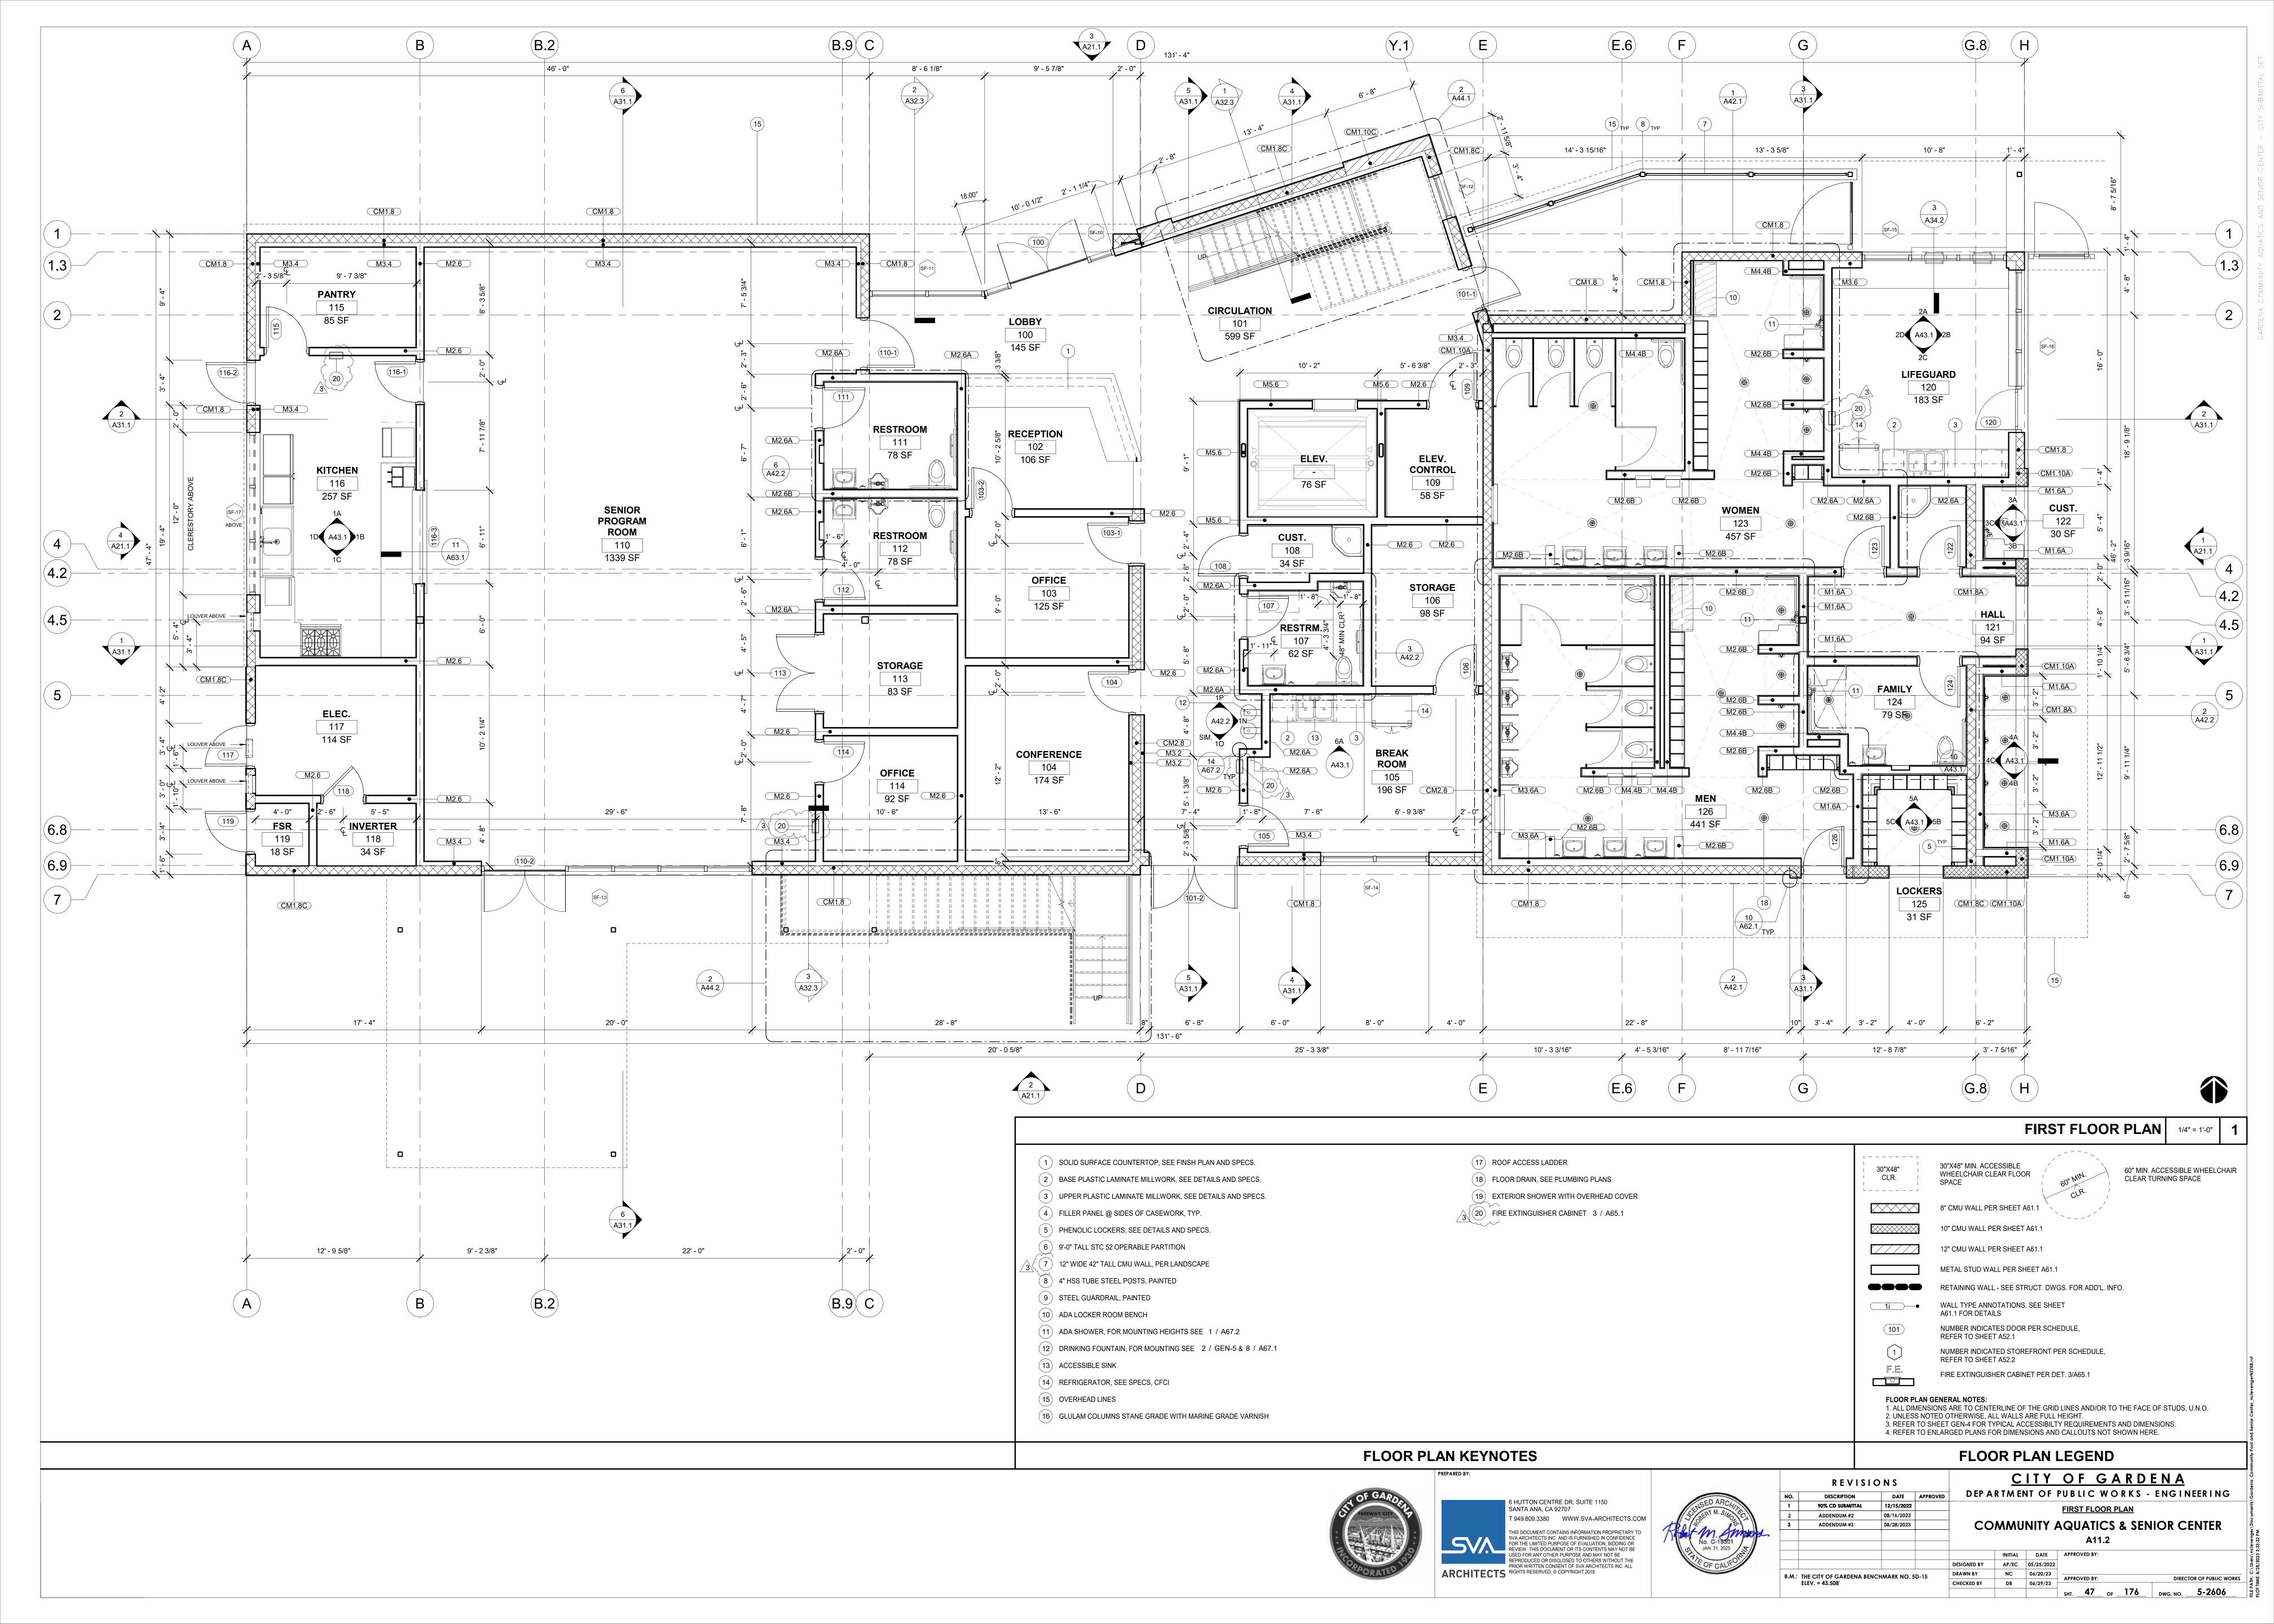


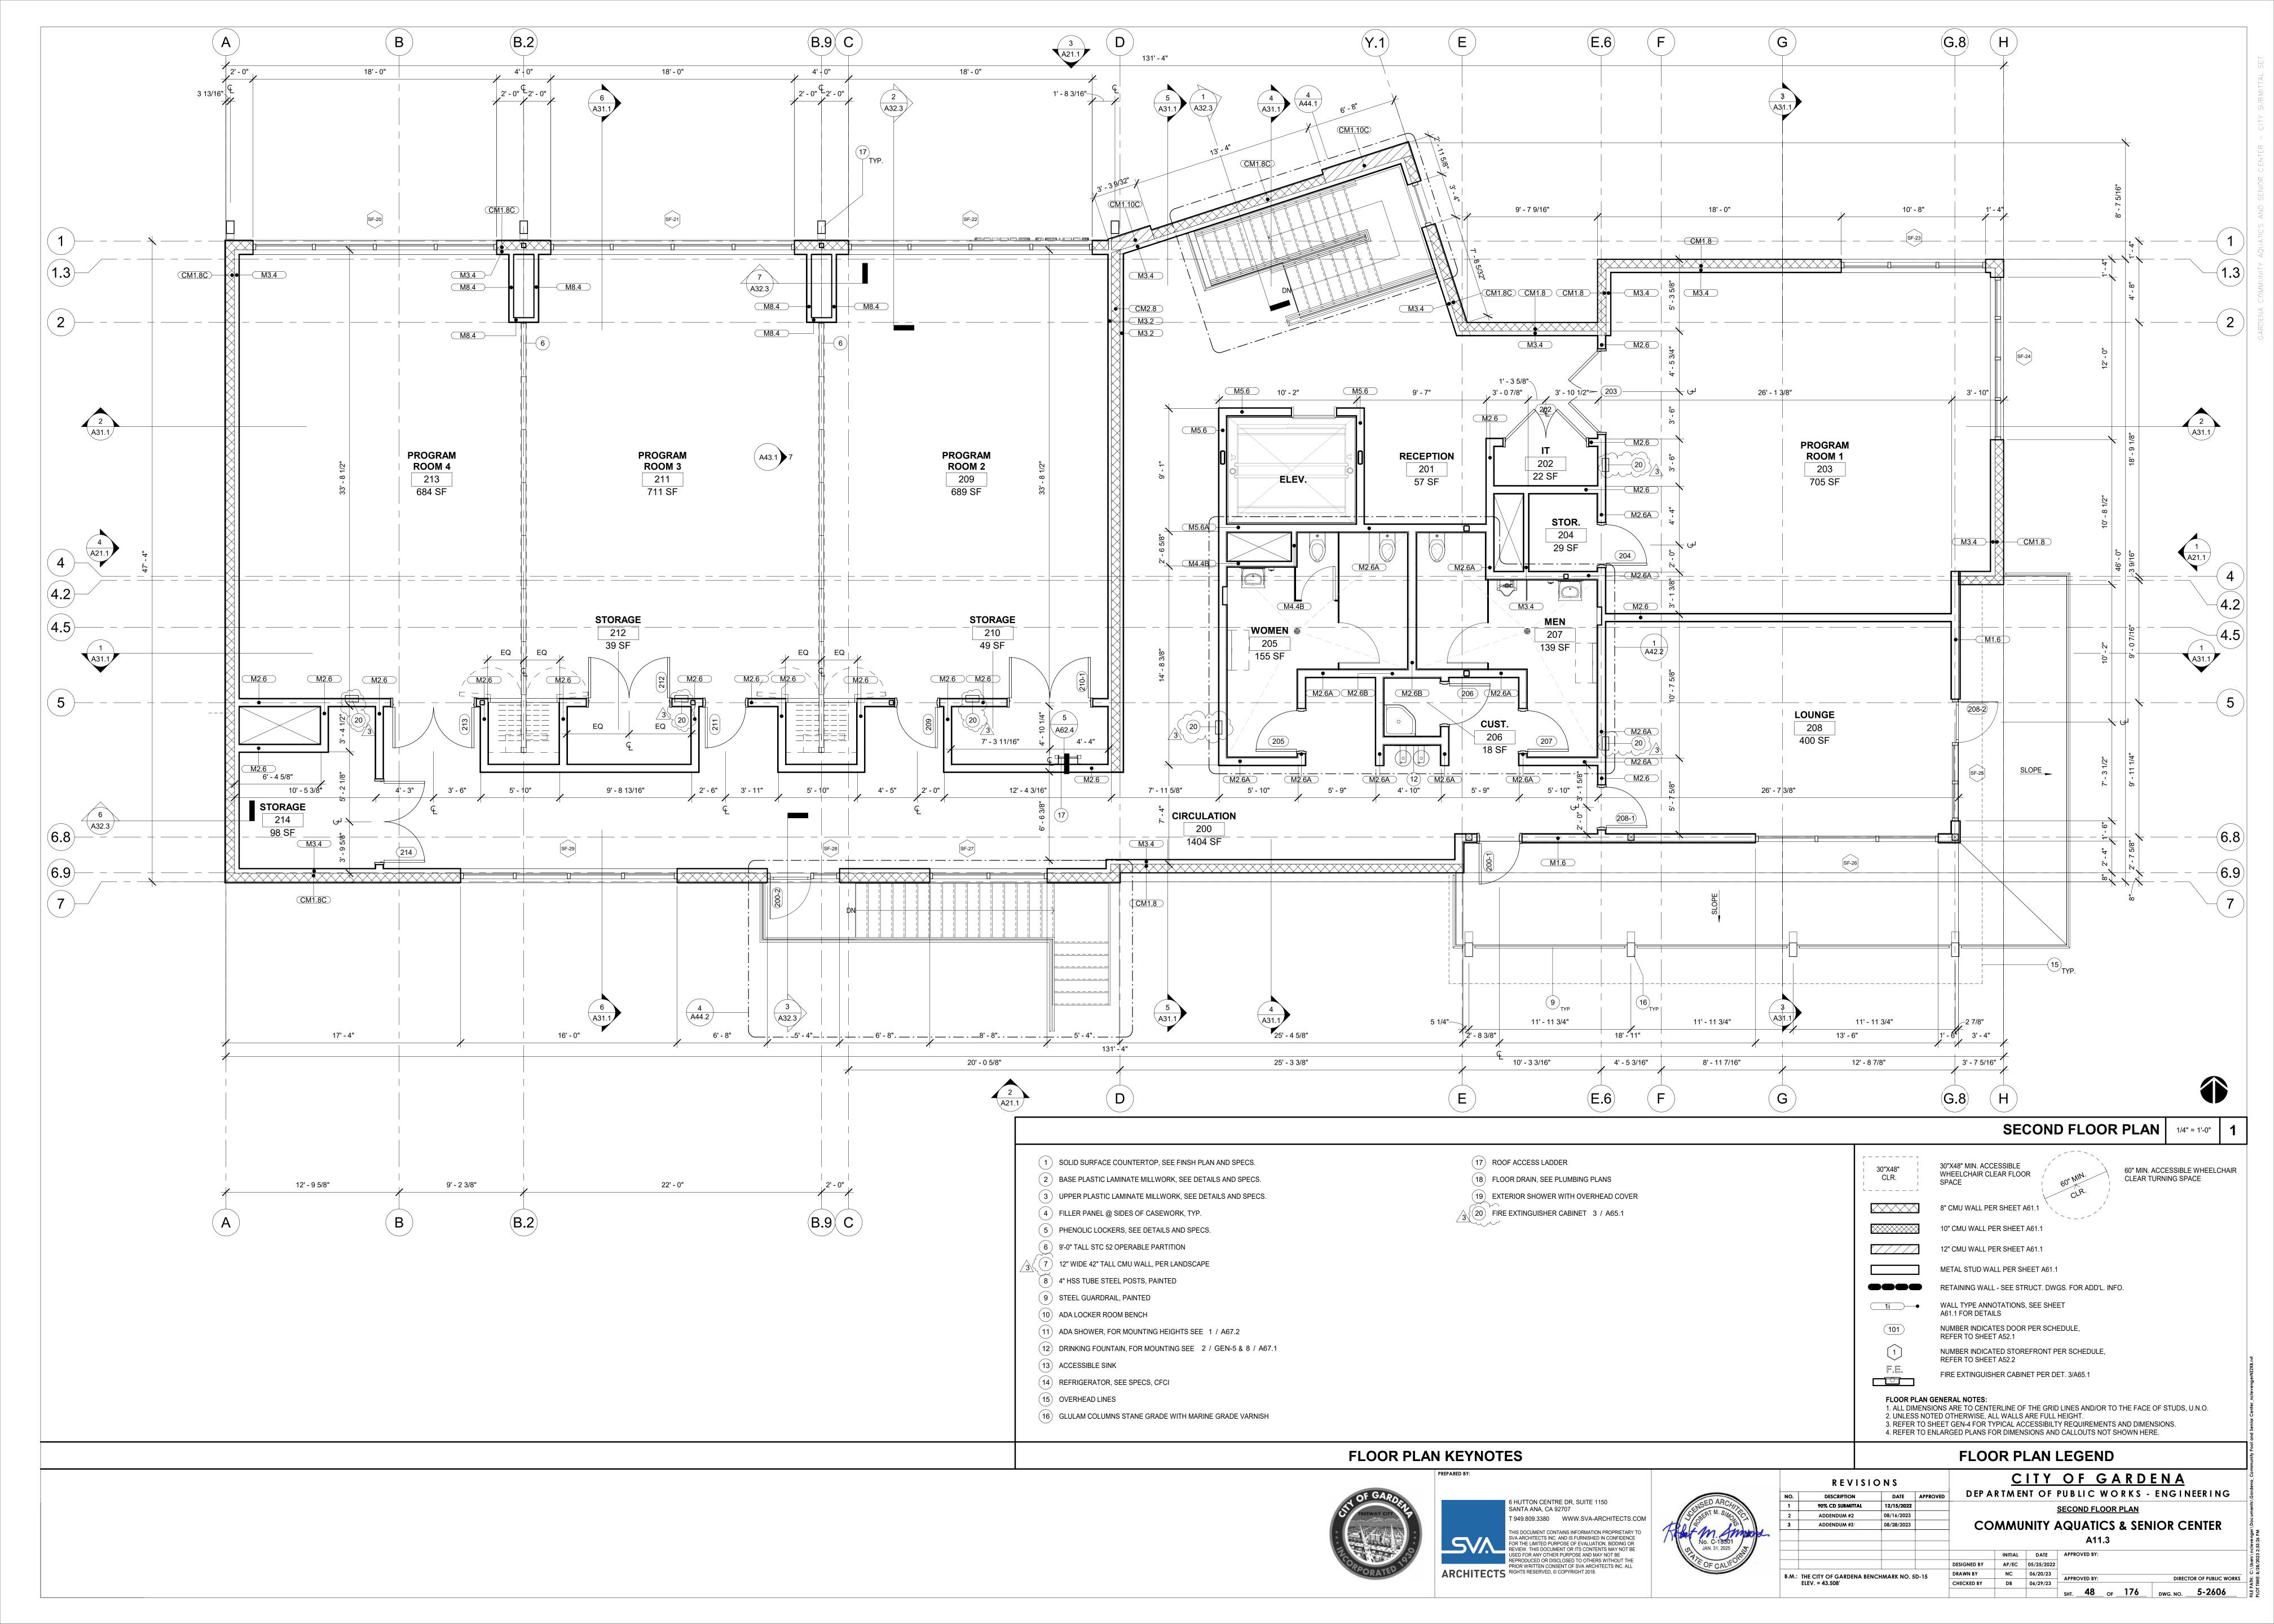


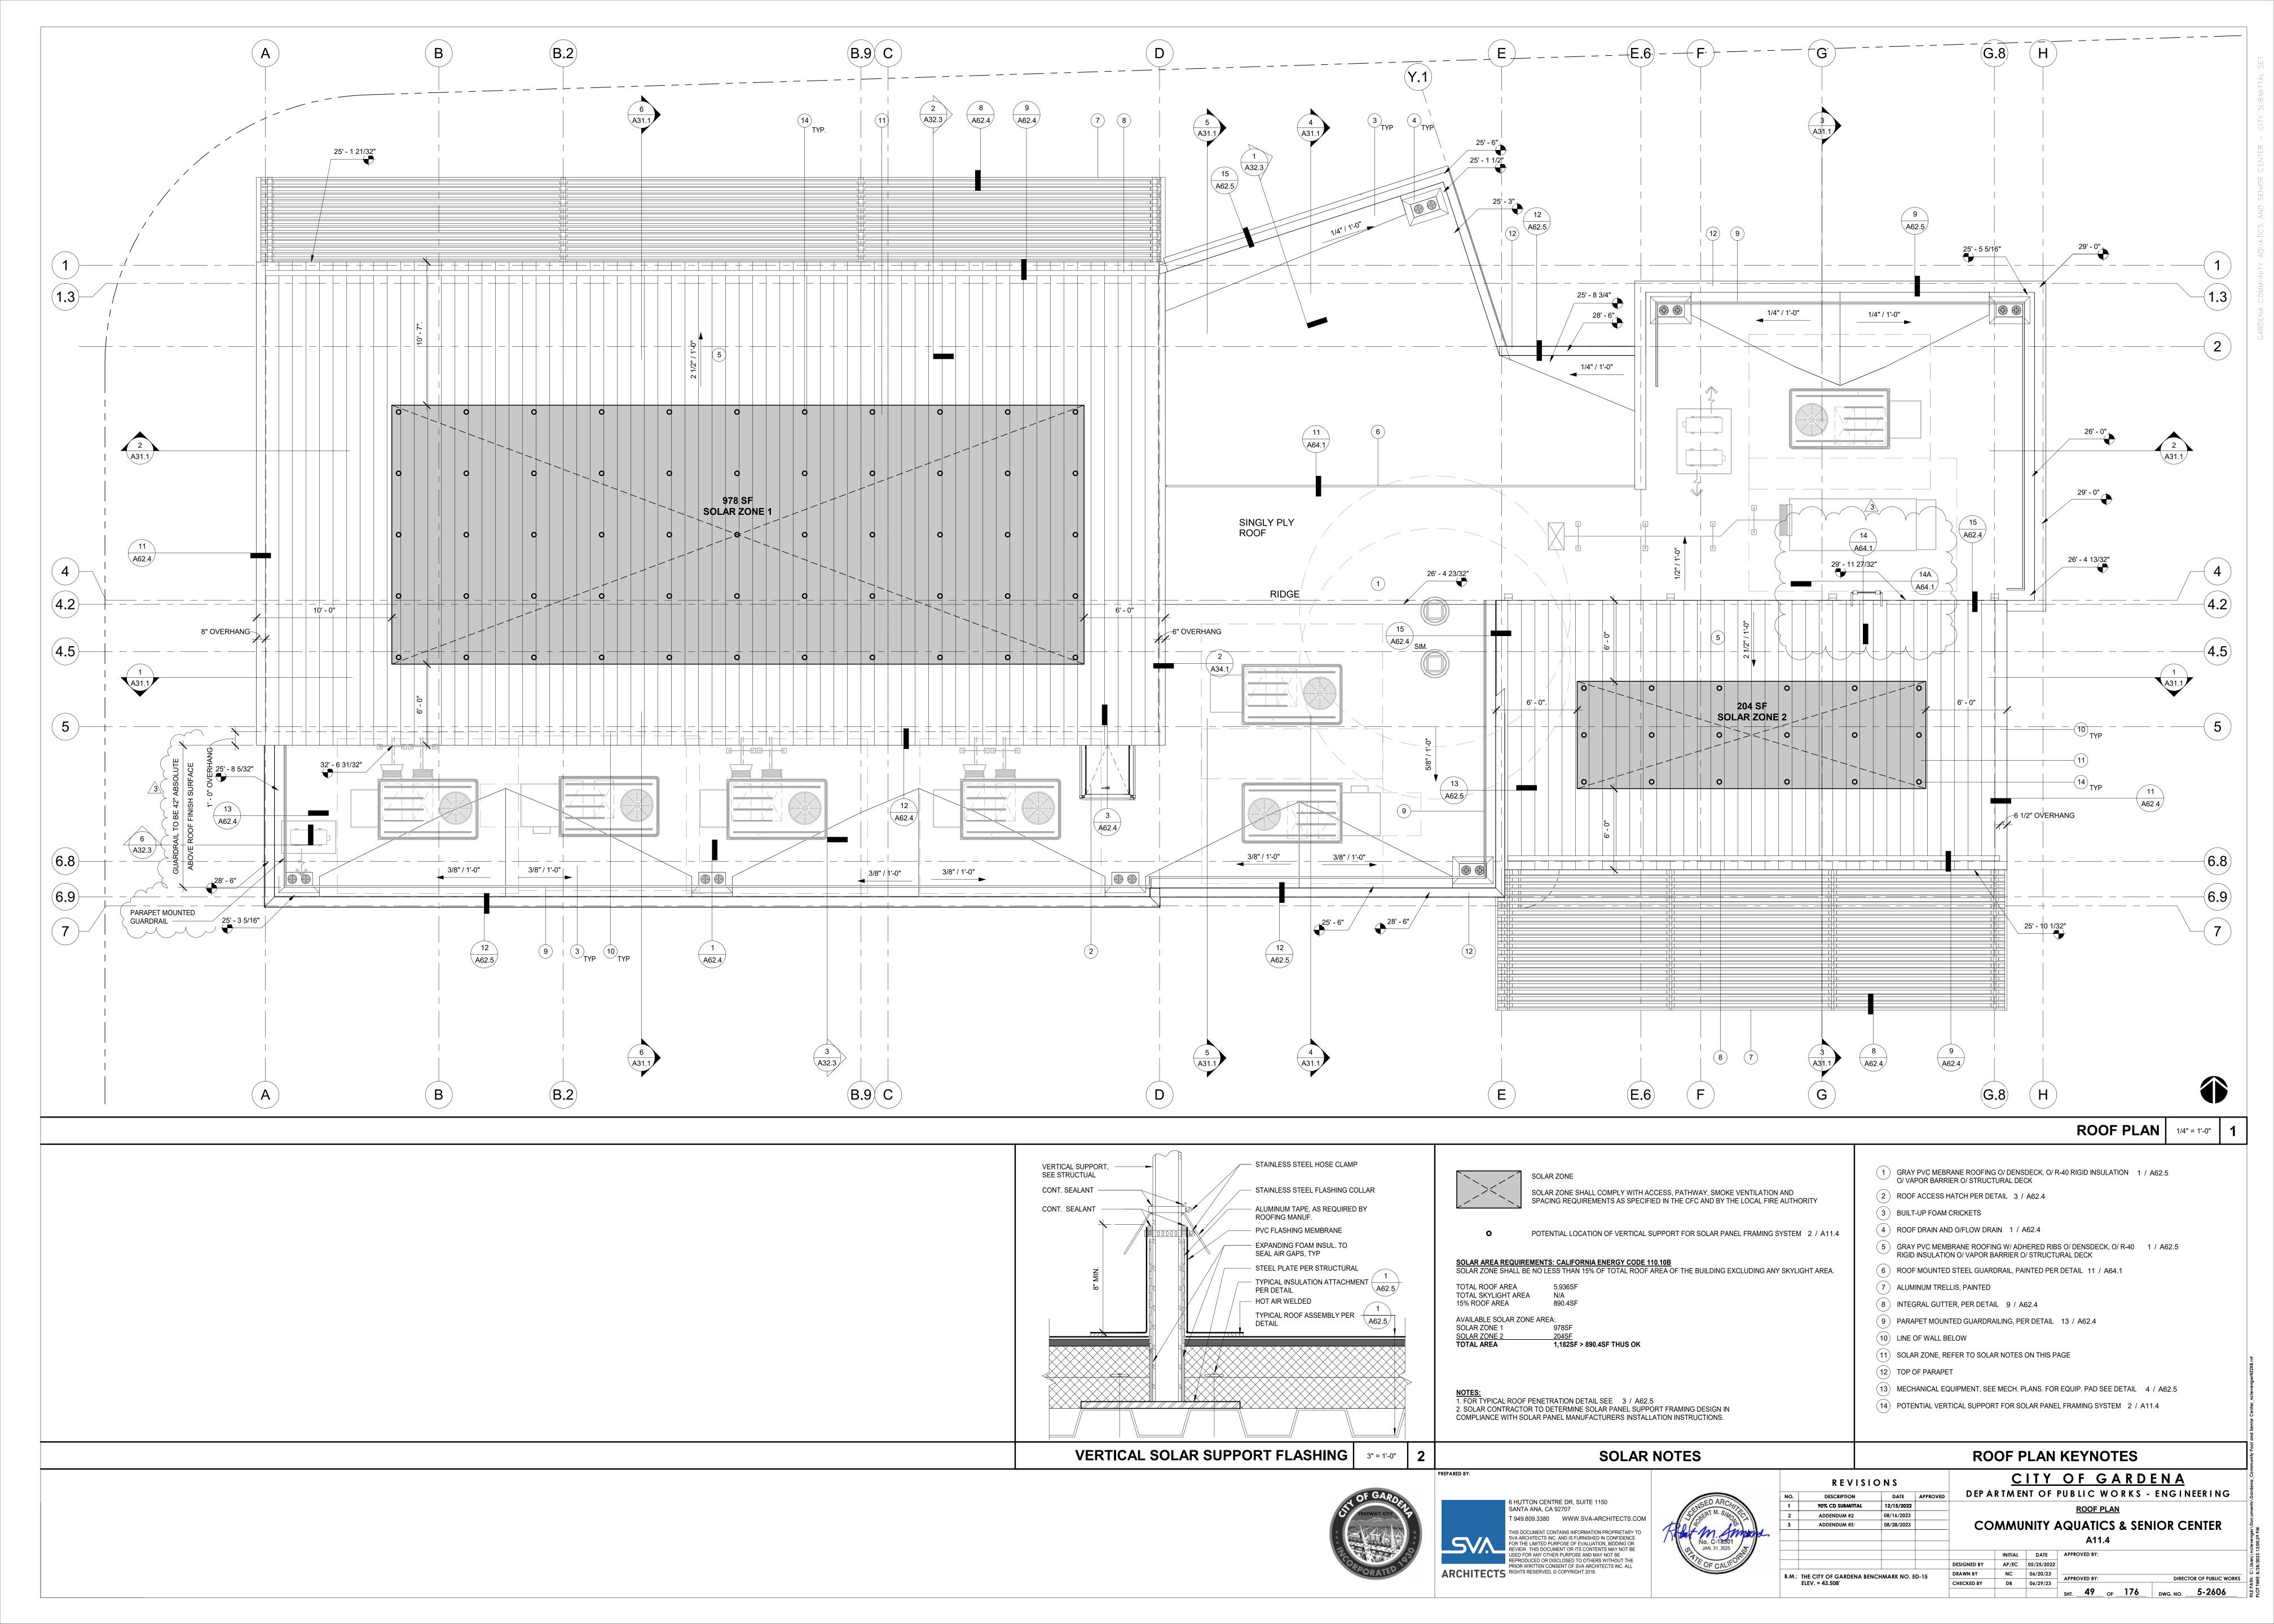


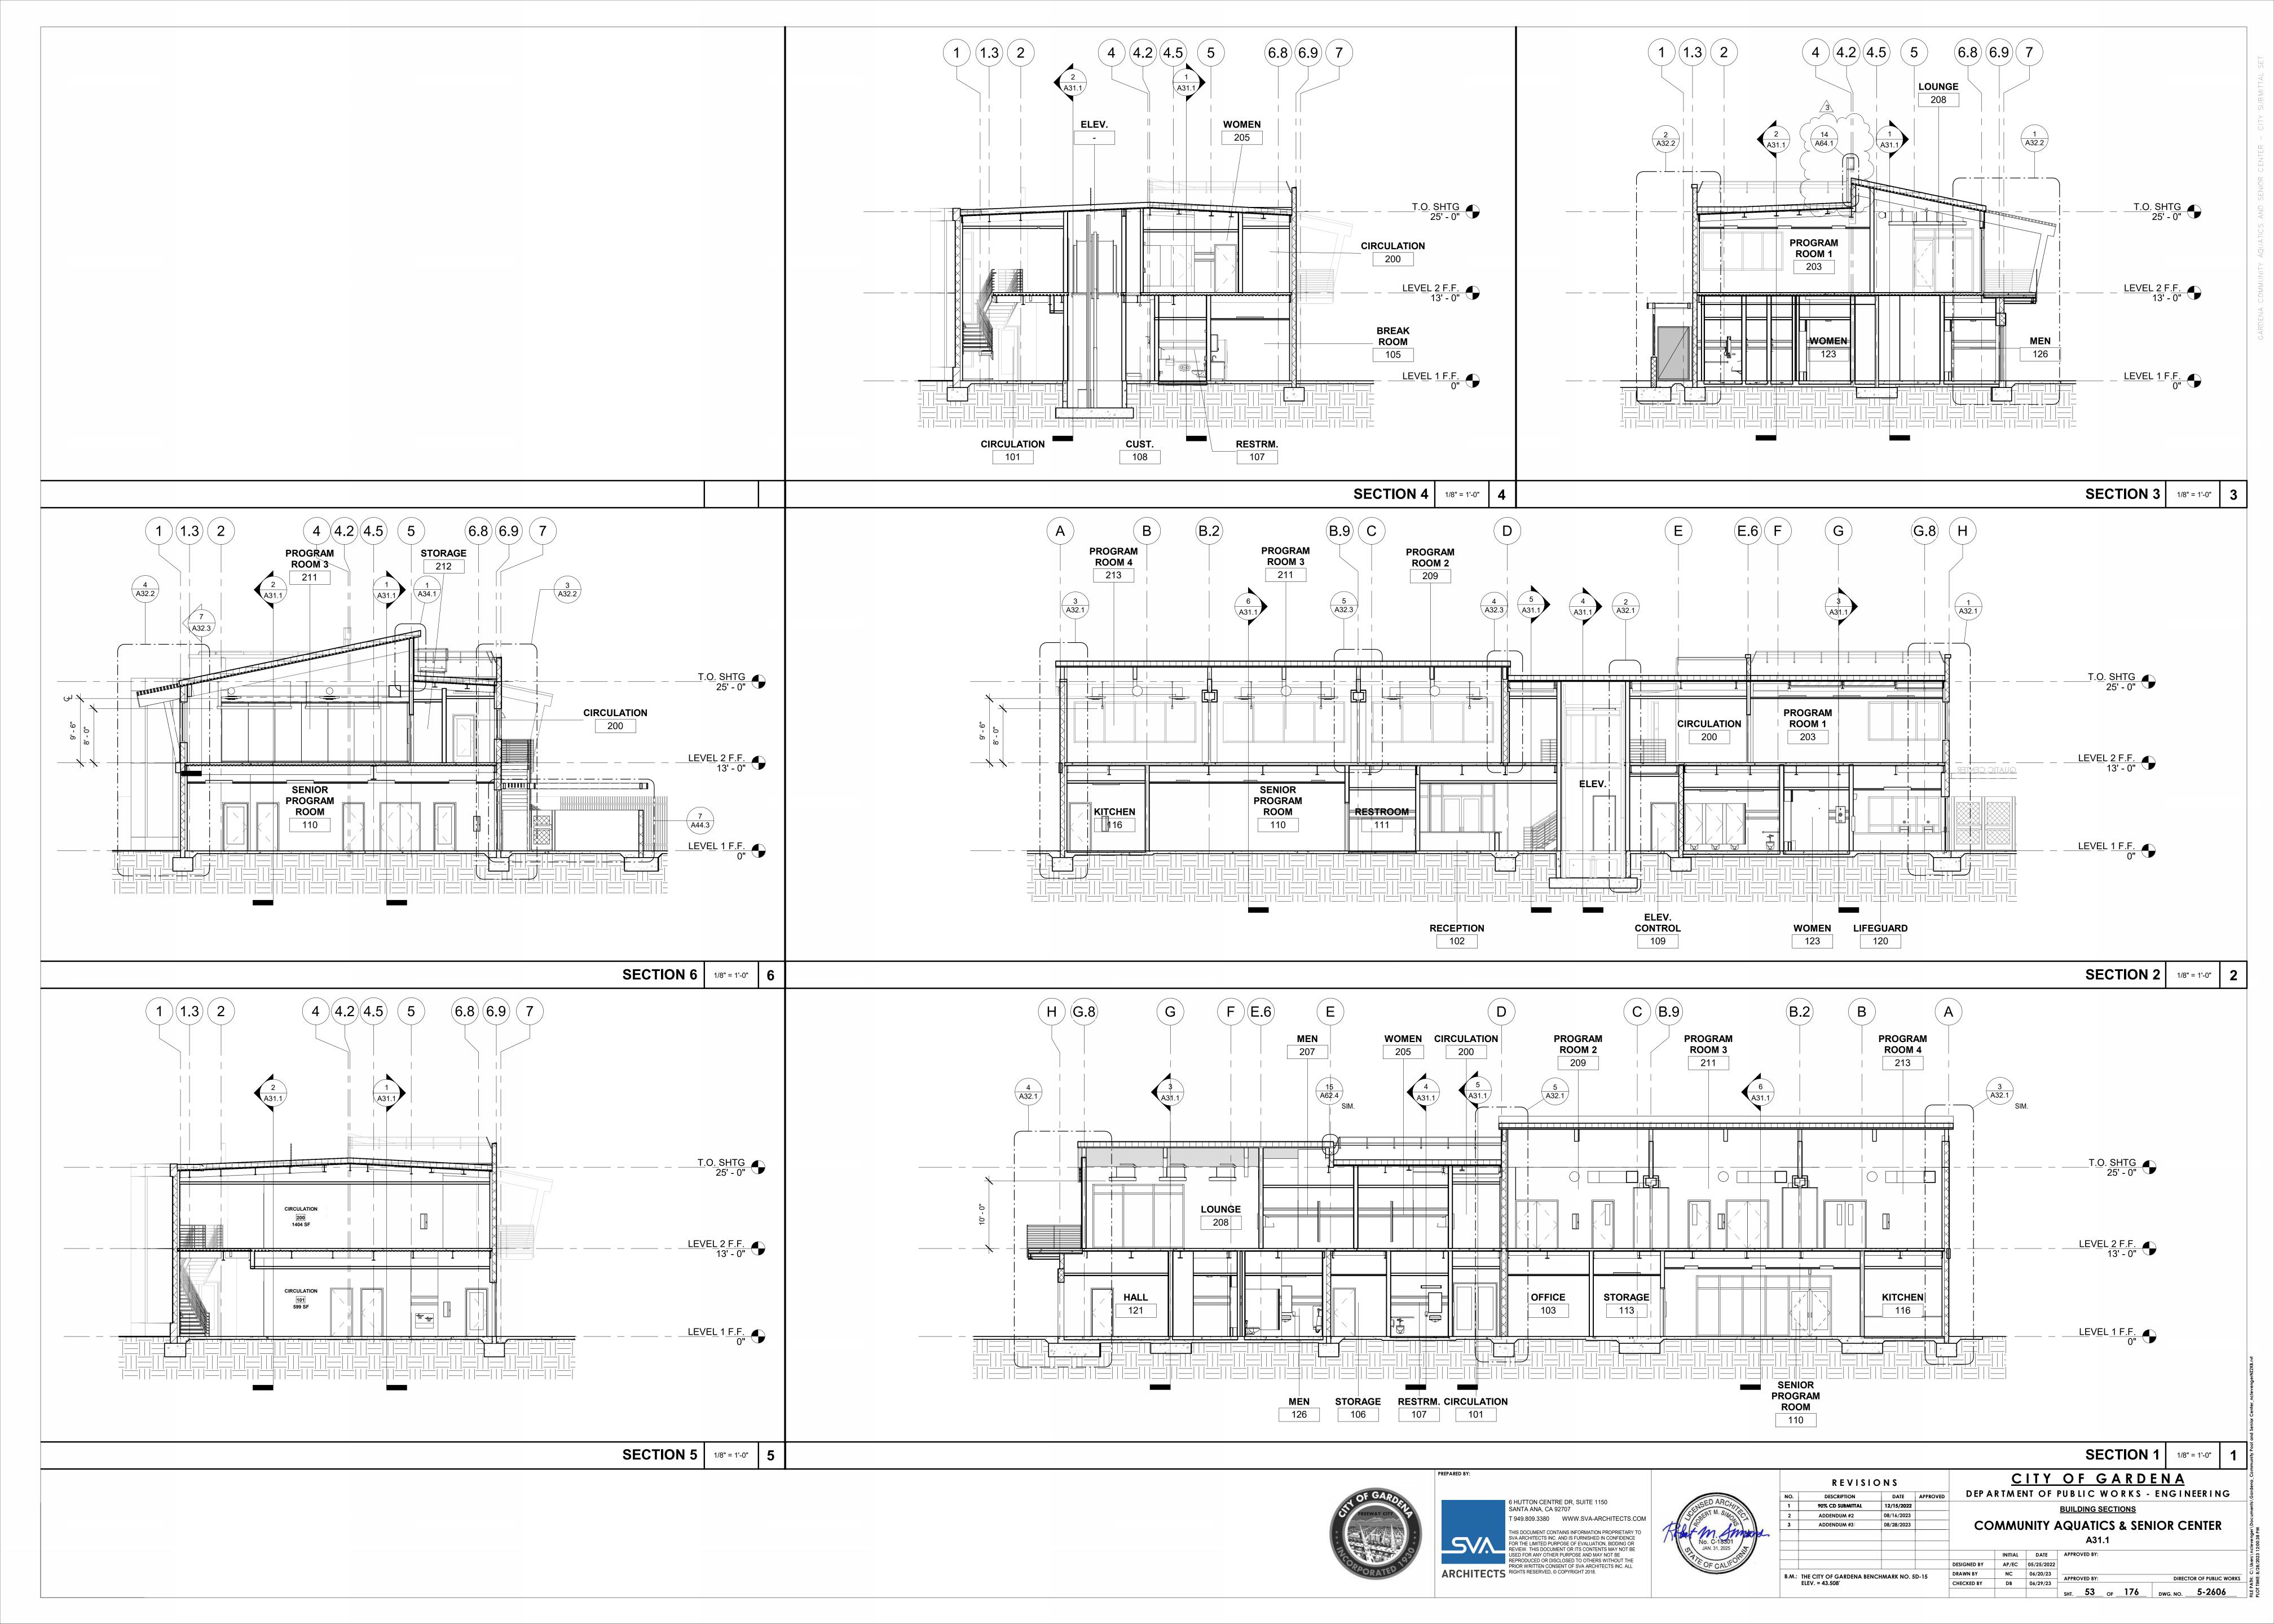

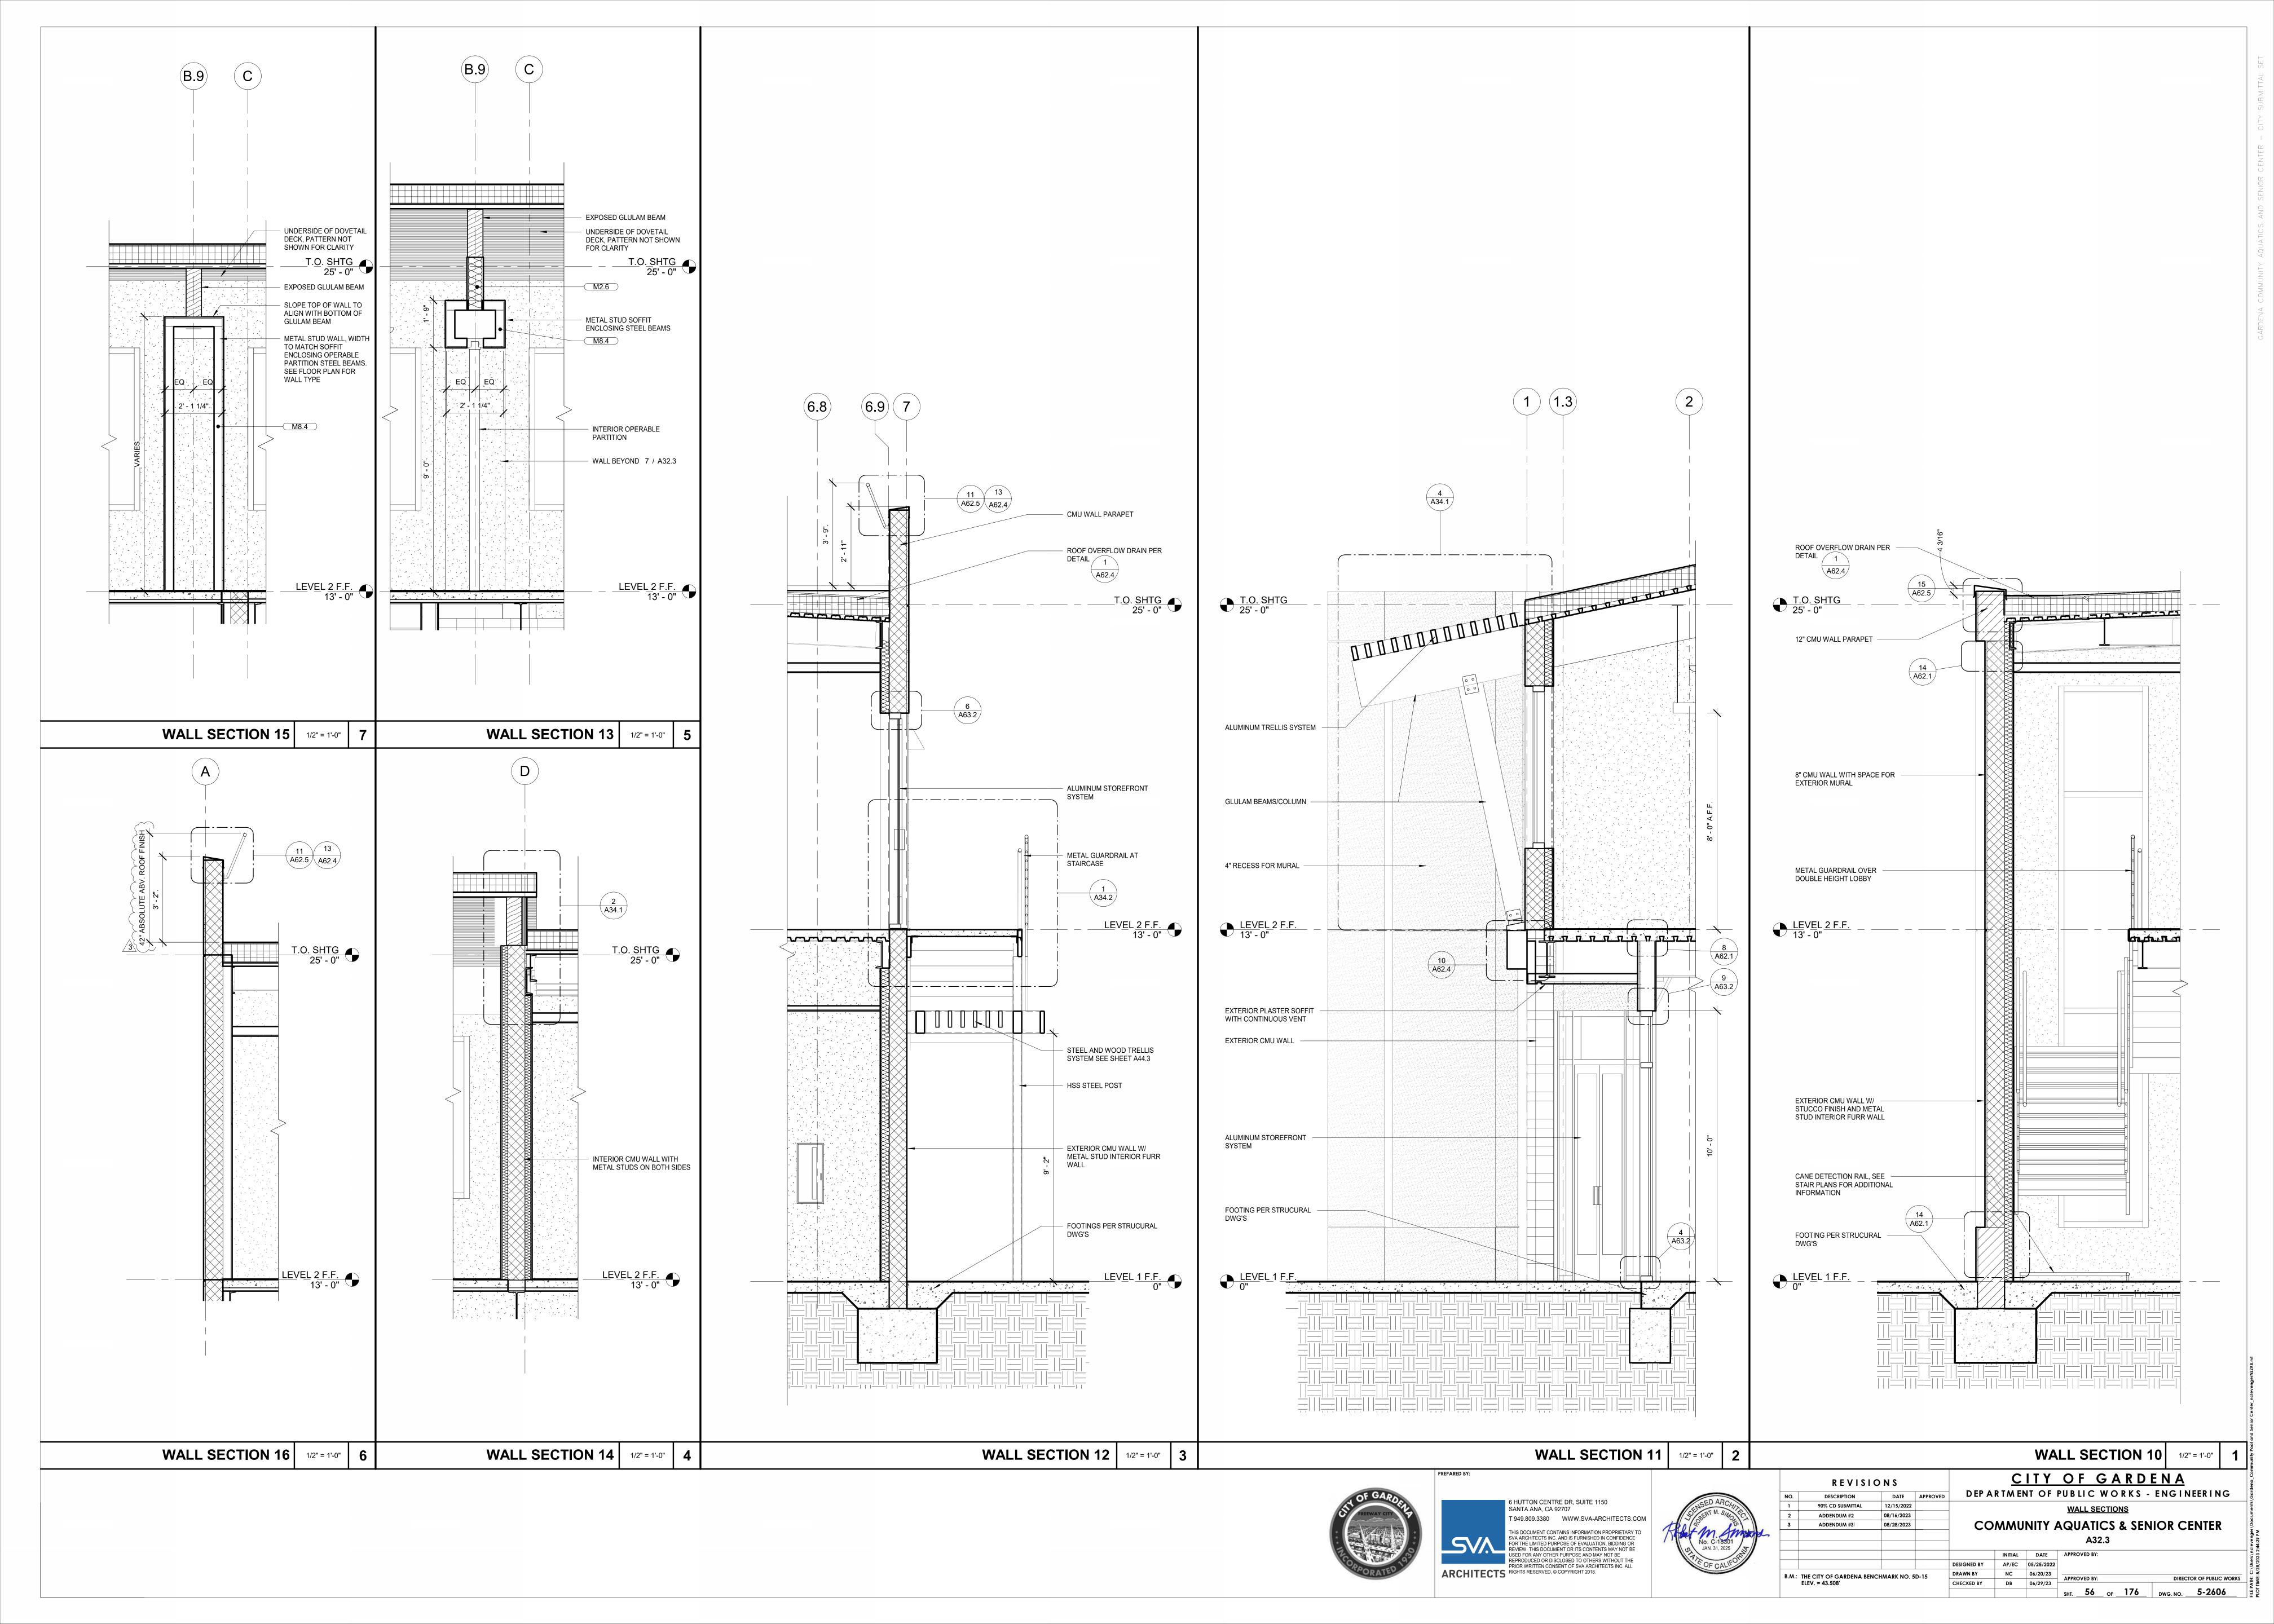

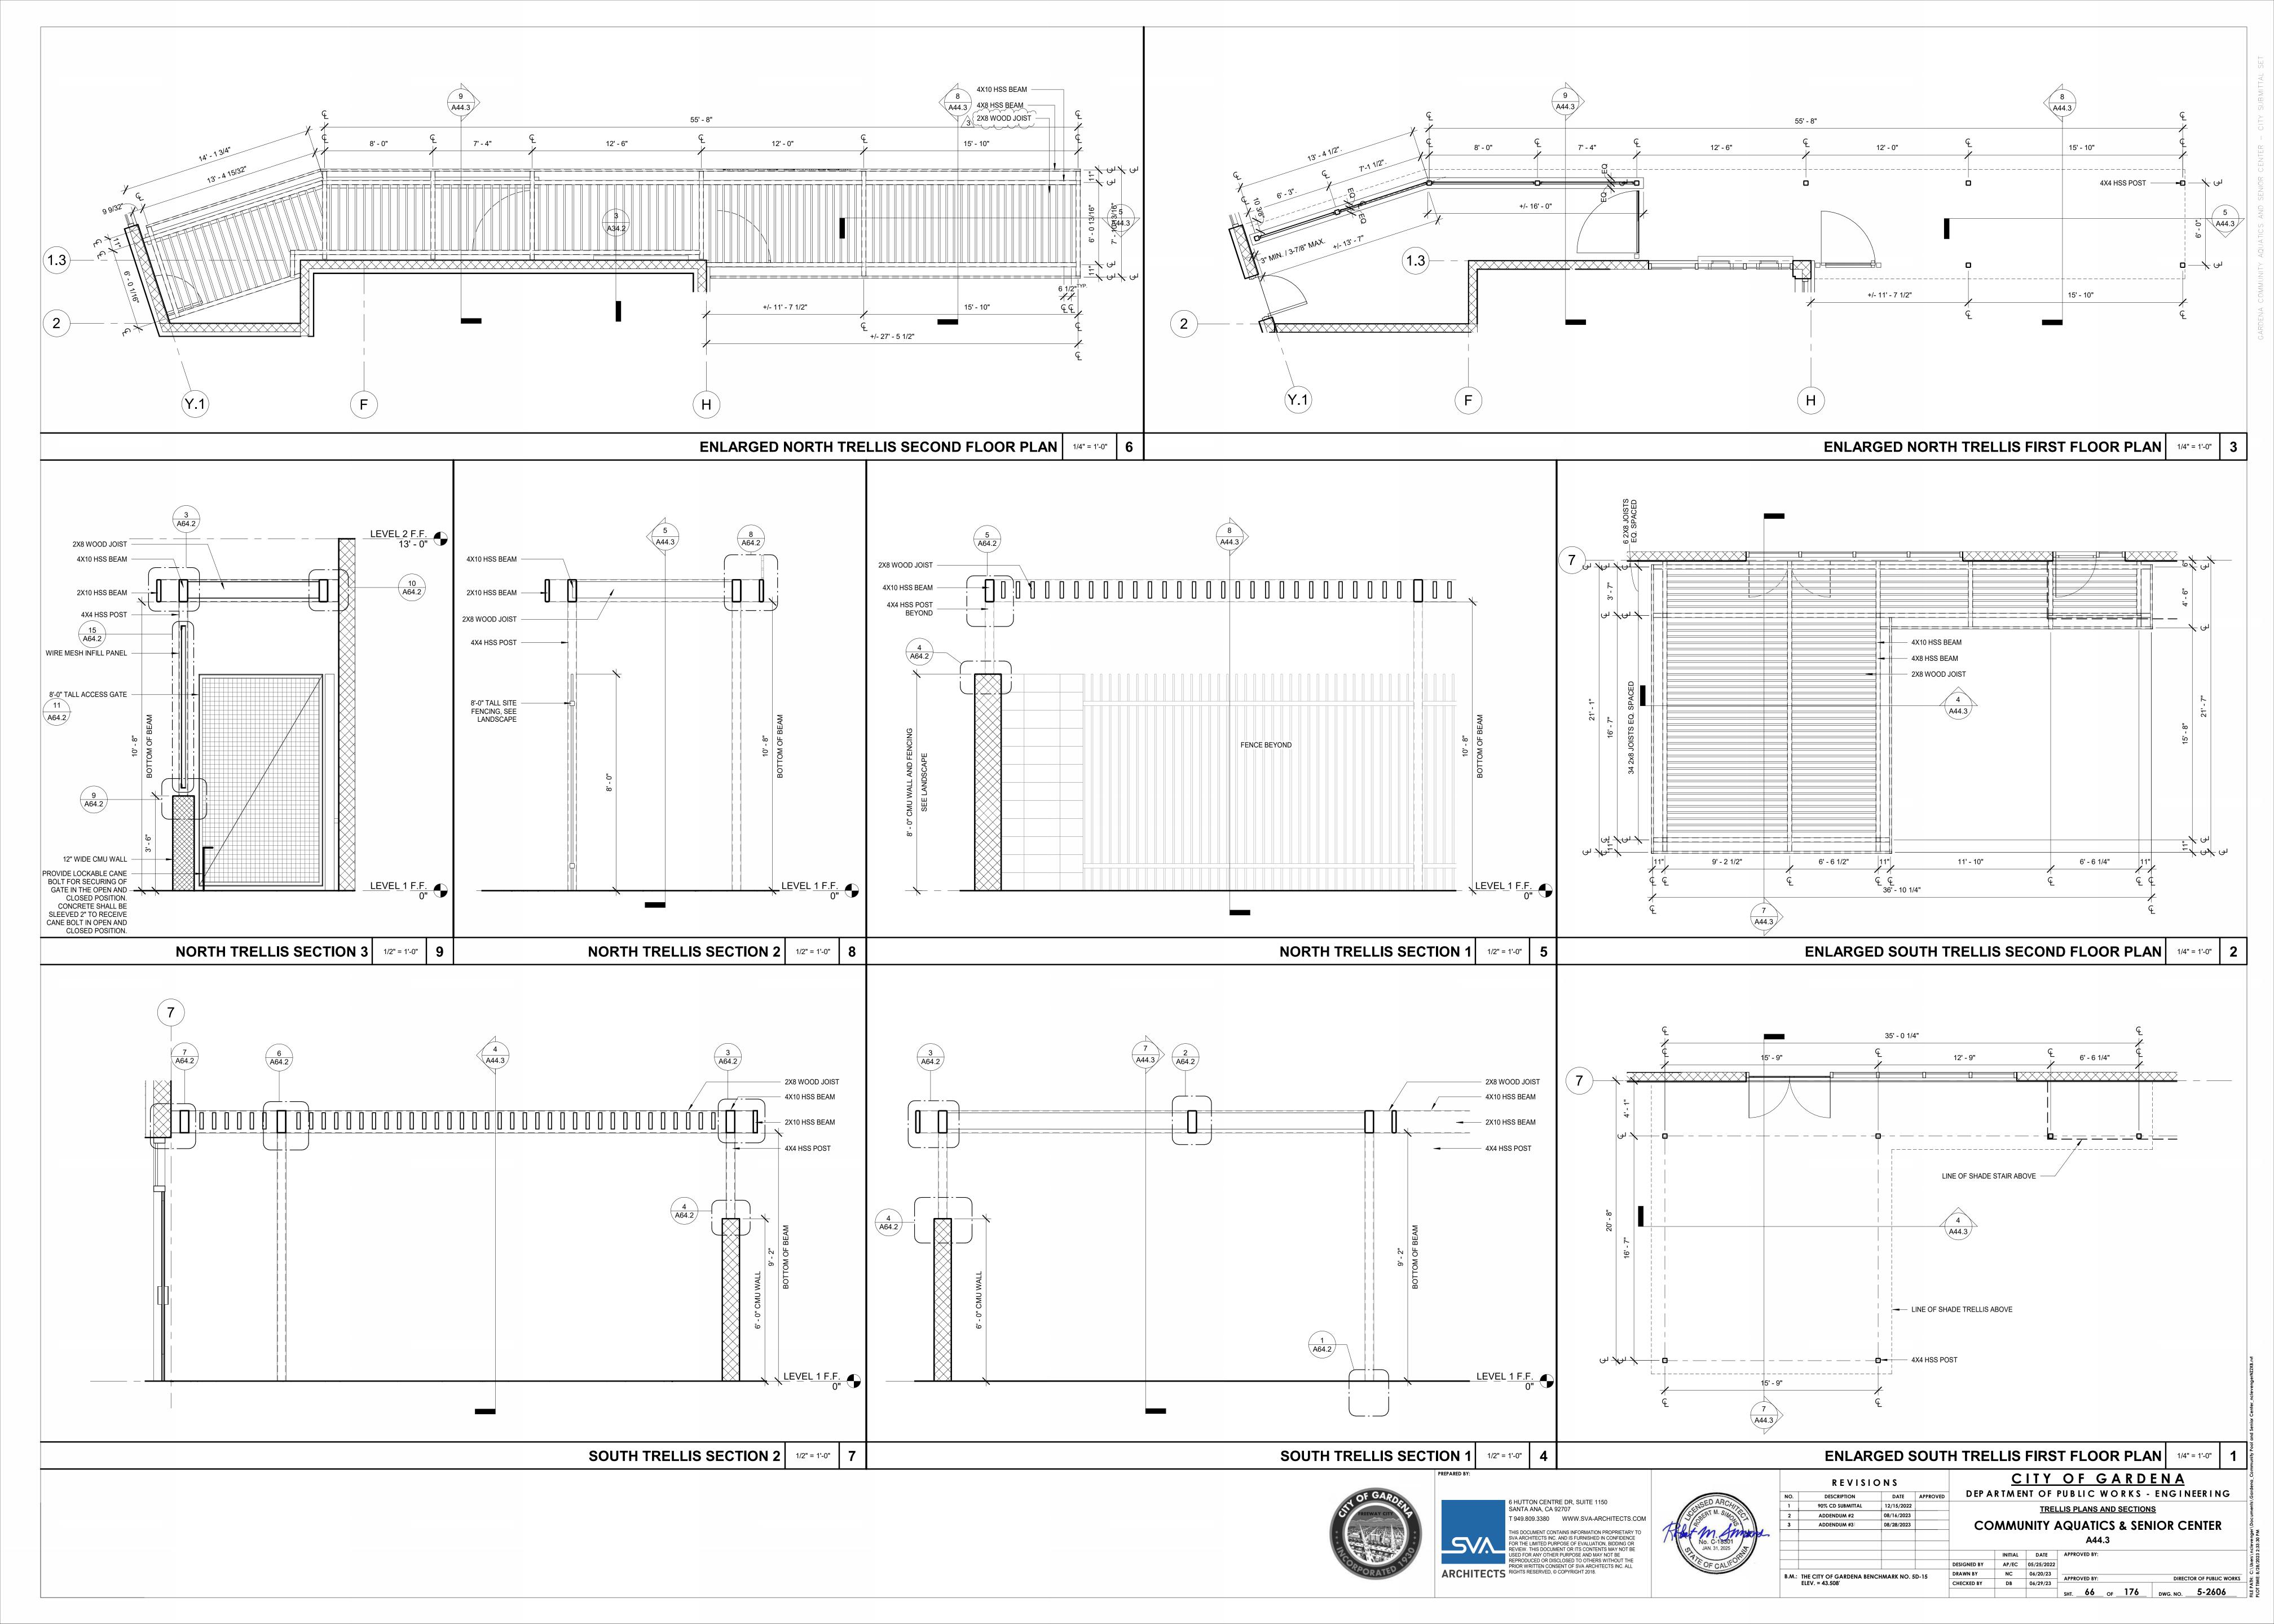

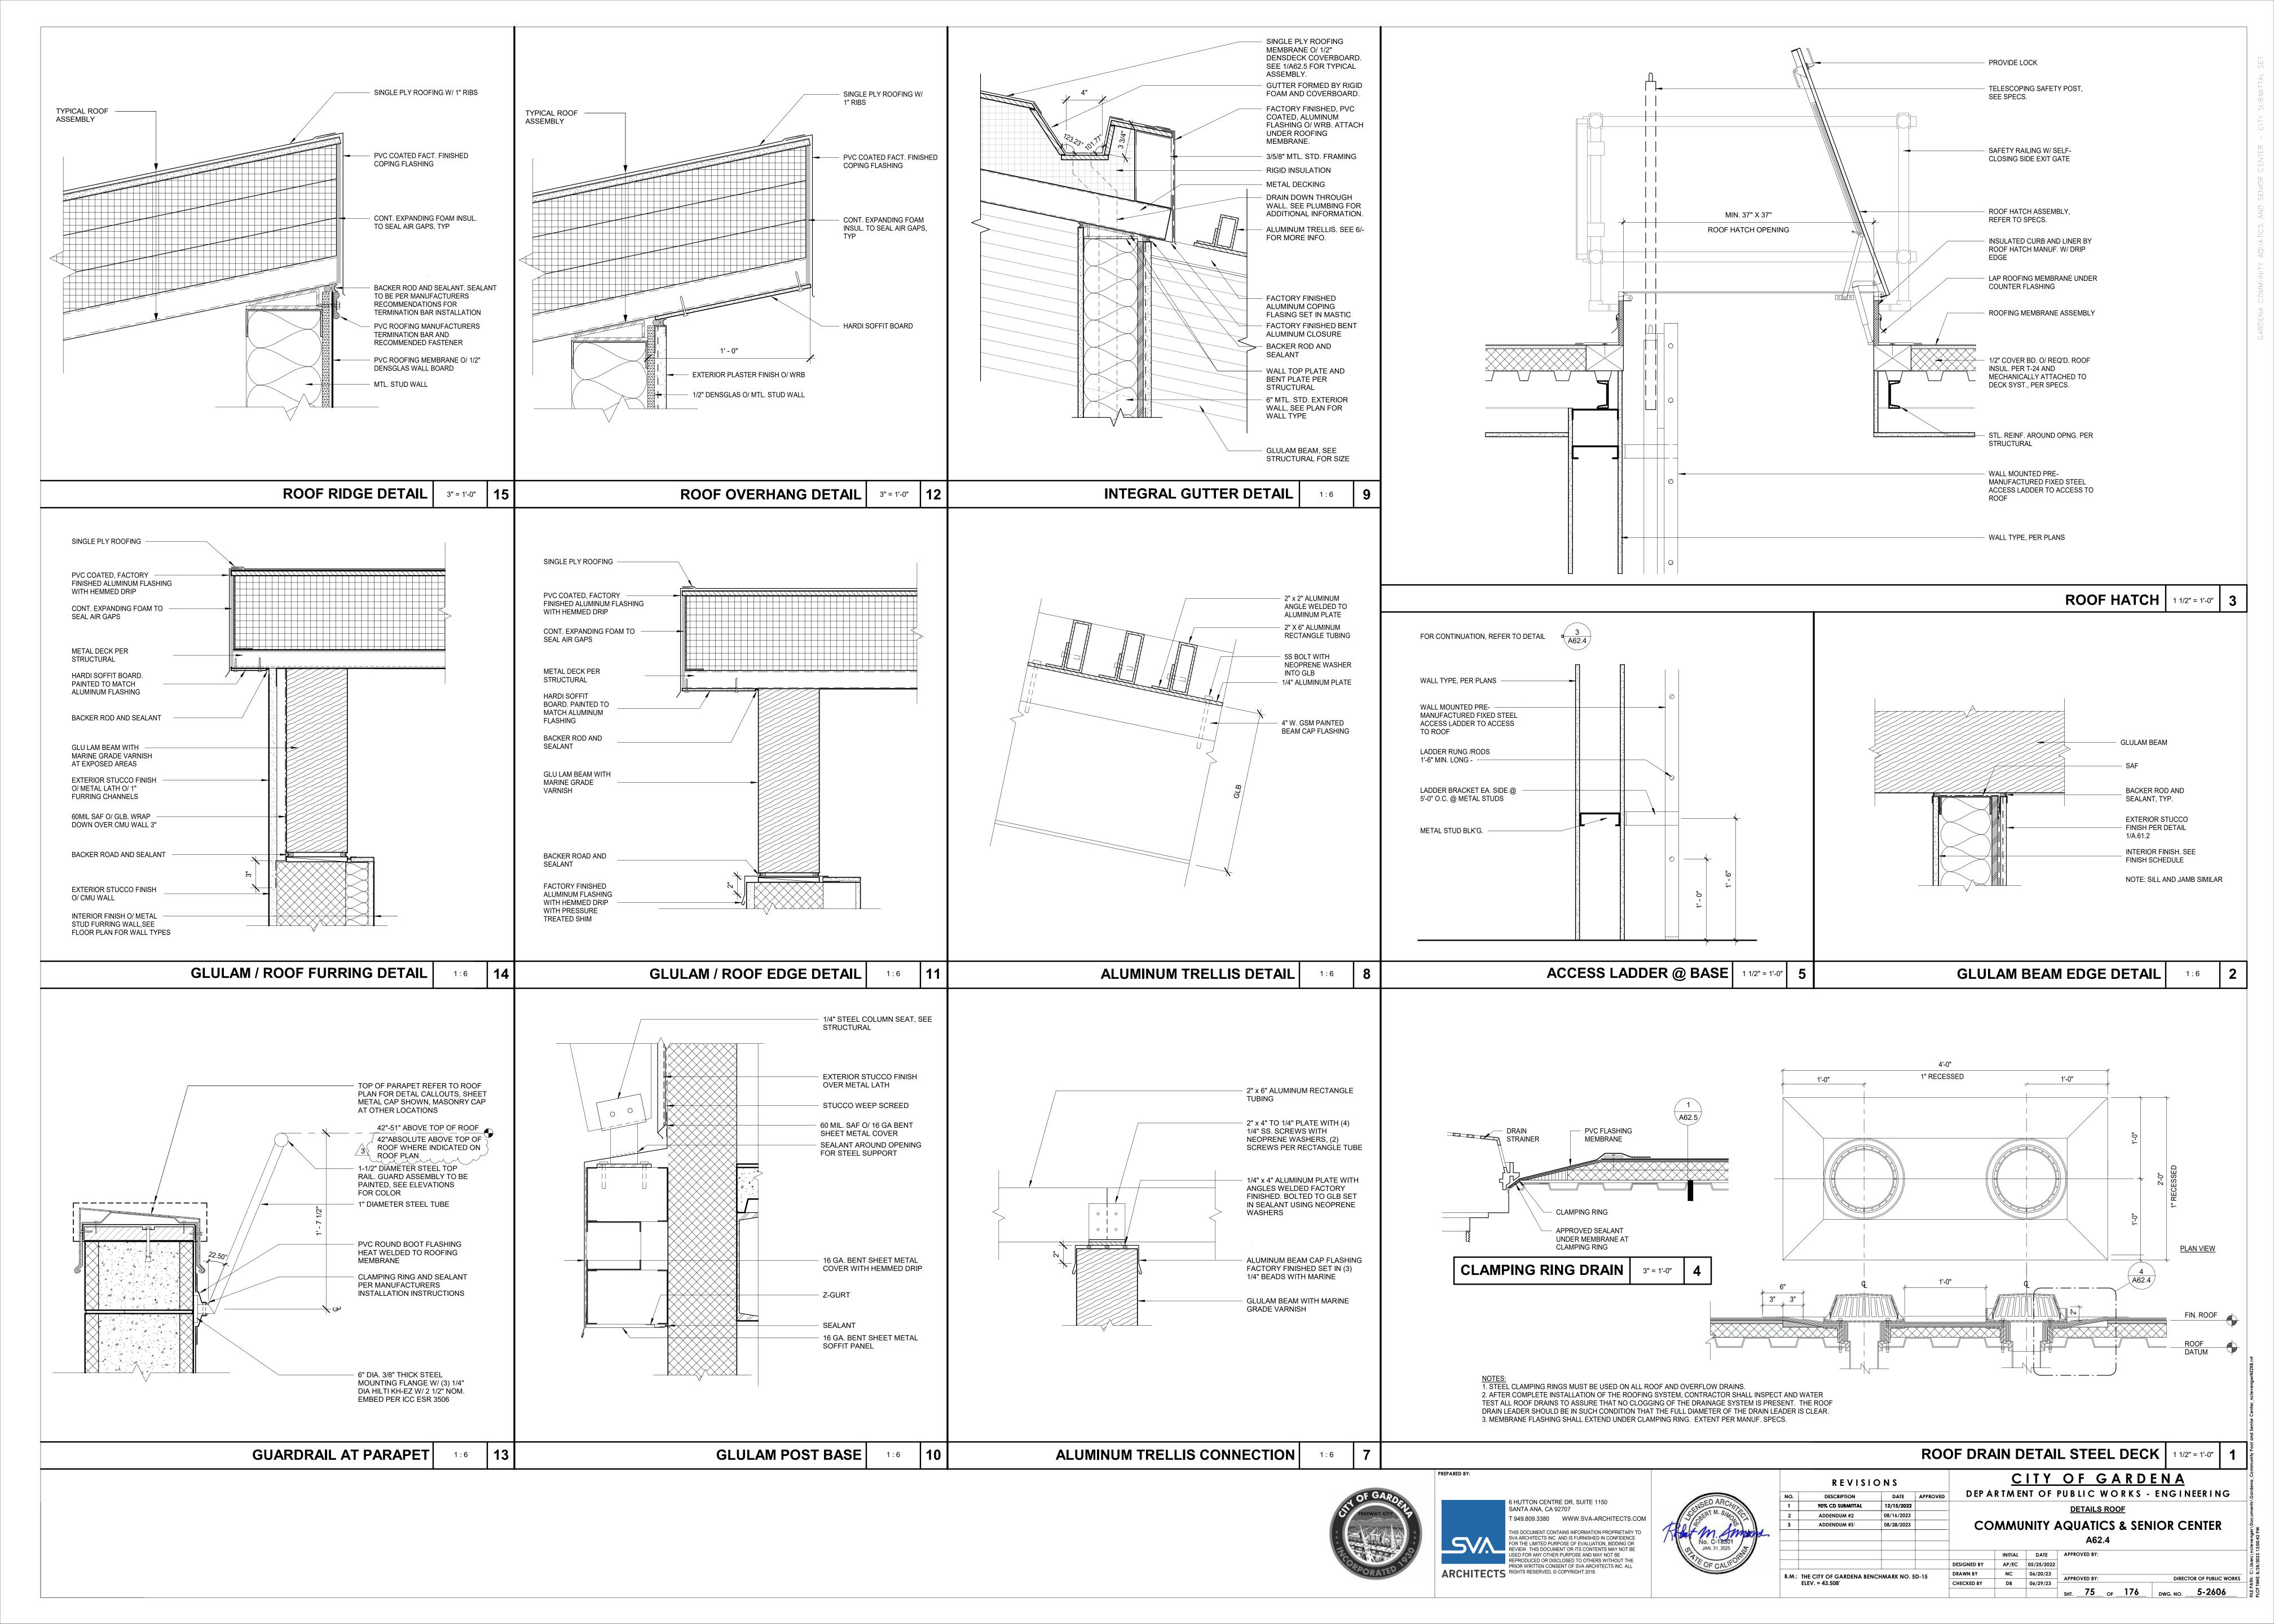

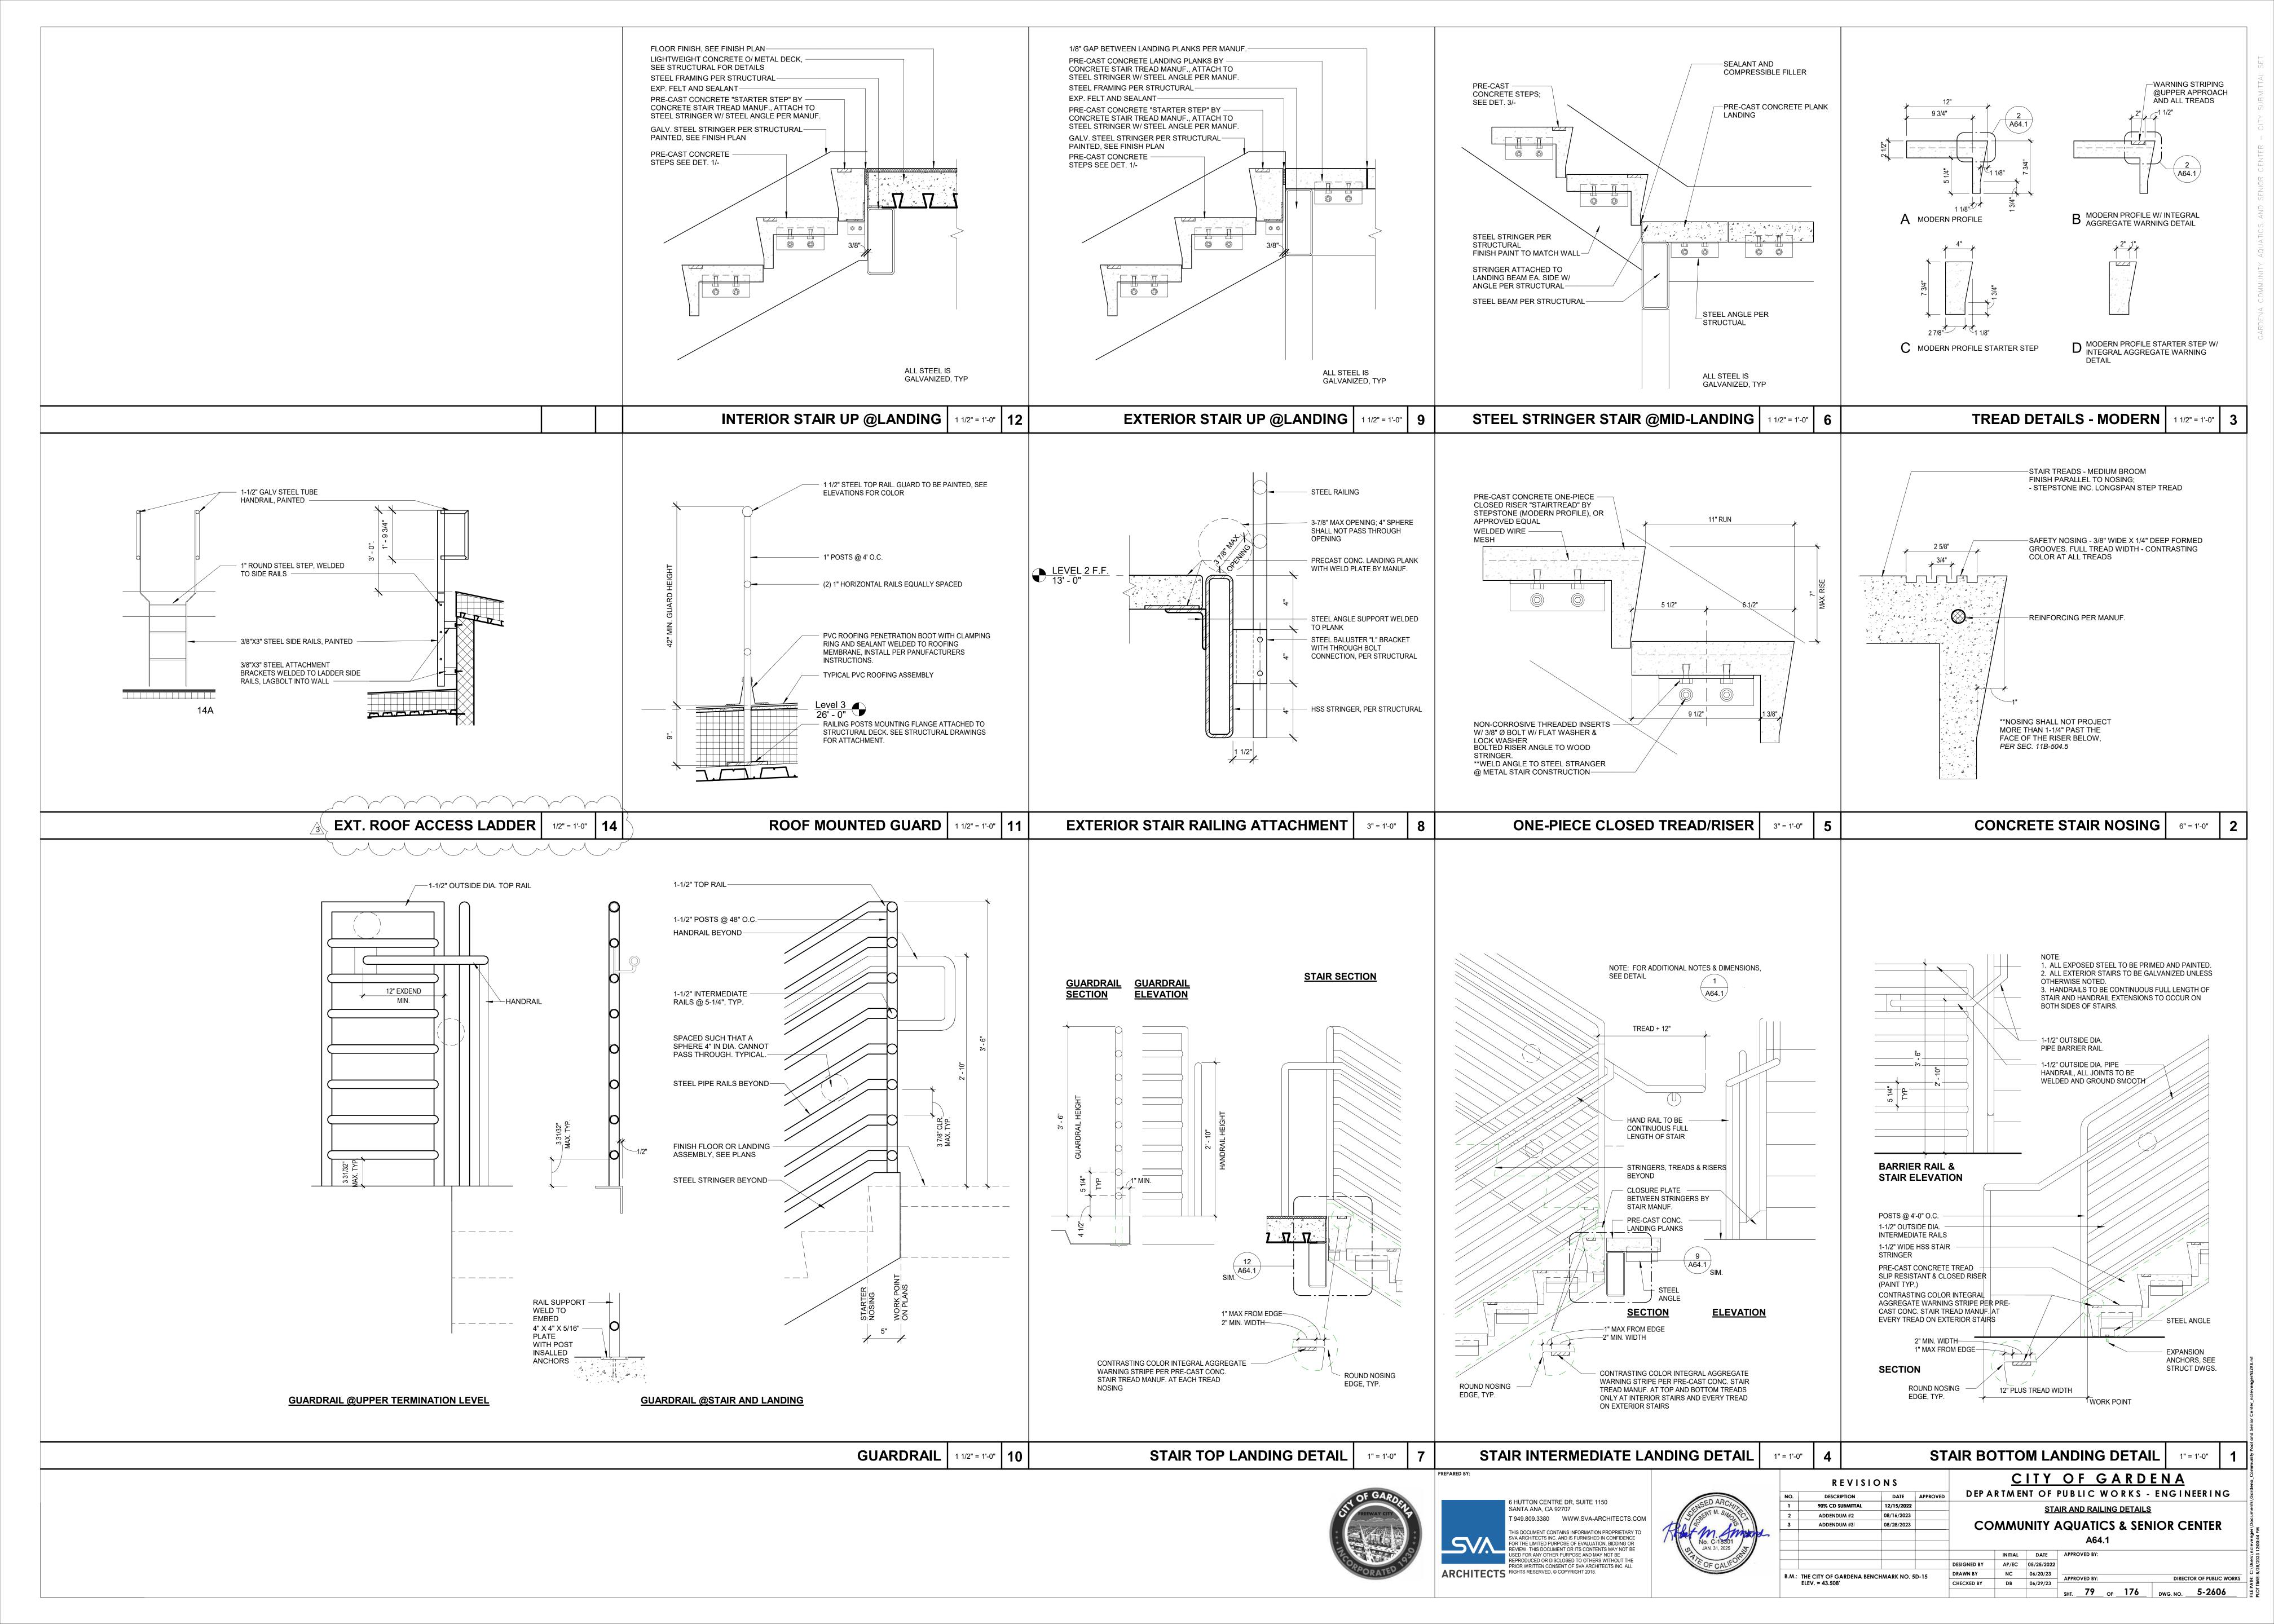

FOUNDATION NOTES

- 1. FOR GENERAL NOTES, SEE S-0.# SERIES.
- 2. FOR TYPICAL DETAILS, SEE S-1.# SERIES.
- 3. NONE.
- 4. SF-# INDICATES SPREAD FOOTING. SEE SPREAD FOOTING SCHEDULE FOR ADDITIONAL INFO.

SPREAD FOOTING SCHEDULE							
MARK		DIMENSIO	REINFORCEMENT				
	LENGTH	WIDTH	DEPTH	LONG	SHORT		
SF-4	4' - 0"	4' - 0"	24"	(4)-#5 T&B	(4)-#5 T&B		
SF-6.5	6' - 6"	6' - 6"	24"	(6)-#7 T&B	(6)-#7 T&B		
SF-8	8' - 0"	8' - 0"	24"	(8)-#7 T&B	(8)-#7 T&B		

- 5. DRAWING DATUM = 0'-0": REF. ELEV. +/- XXX.XX @ GROUND FLOOR FINISH FLOOR (SEE CIVIL & ARCH FOR ACTUAL ELEVATION)
- 6. FOR WALL FOOTING THRU / TERMINATION DETAIL SEE 11 / S-1.10
- 7. TYPICAL SLAB ON GRADE UNDERLAYMENT:
 SLAB SHALL BE UNDERLAIN BY 4 INCHES OF SAND LAYER
 OVER 15 MIL MOISTURE BARRIER
 CONTRACTOR TO PROTECT VAPOR BARRIER FROM PUNCTURE.
- 8. FOR SLAB SAWCUT AND CONTROL JOINT, SEE DETAIL 16 / S-1.1

& FOR TYPICAL SLAB EDGE, SEE 9 / S-1.1

ONTRACTOR SHALL COORDINATE ALL NEW AND EXISTING UTILITIES PRIOR TO ANY FOUNDATION WORK PER 9 / S-1.2 & 5 / S-1.2 STEP FOOTINGS AS REQUIRED PER DETAIL 8 / S-1.2 @ SLRS FRAMES, STEPS NOT NOTED HEREIN REQUIRE SEOR & DSA APPROVAL. WHERE ADDITIONAL STEPS ARE REQUIRED, NOTIFY SEOR.


- 10. SINDICATES STEP IN FOOTING PER DETAIL 8 / S-1.2
 @ SLRS FRAMES, STEPS NOT NOTED HEREIN REQUIRE SEOR & DSA APPROVAL.
- 11. INDICATES DEPRESSED SLAB. SEE DETAIL 9 / S-1.1
 REFER TO ARCHT'L DRAWINGS FOR ADDITIONAL INFORMATION.

 12. SHOWS ELEVATION OF FRAME ELEVATION
- 13. FOR FOUNDATION CROSSINGS / OVERLAPS SEE DET. 2 / S-1.3 , 3 / S-1.3 & 5 / S-1.3

13.1 FOR STEEL COLUMN BASE PLATES, SEE DET. 2 / S-1.10

- 14. CONC. MASONRY WALL SEE ELEV FOR ADDITIONAL INFOMATION.
- 15. WF-# INDICATES WALL FOOTING.

		WALL F	OOTING SCHEDULE	
MADIC	DIMENSIONS		DEINEODOEMENT	#4 TIES @ 12" O.C., U.N.O.
MARK WID	WIDTH	DEPTH	REINFORCEMENT	
VF-1.5	1' - 6"	24"	(3)-#5 T&B	ALT. CAP
VF-2	2' - 0"	24"	(3)-#5 T&B	
VF-2.5	2' - 6"	24"	(3)-#5 T&B	
VF-3	3' - 0"	24"	(4)-#5 T&B	
VF-4	4' - 0"	24"	(5)-#5 T&B	
VF-5	5' - 0"	24"	(5)-#5 T&B	
VF-10	10' - 0"	24"	(10)-#5 T&B	

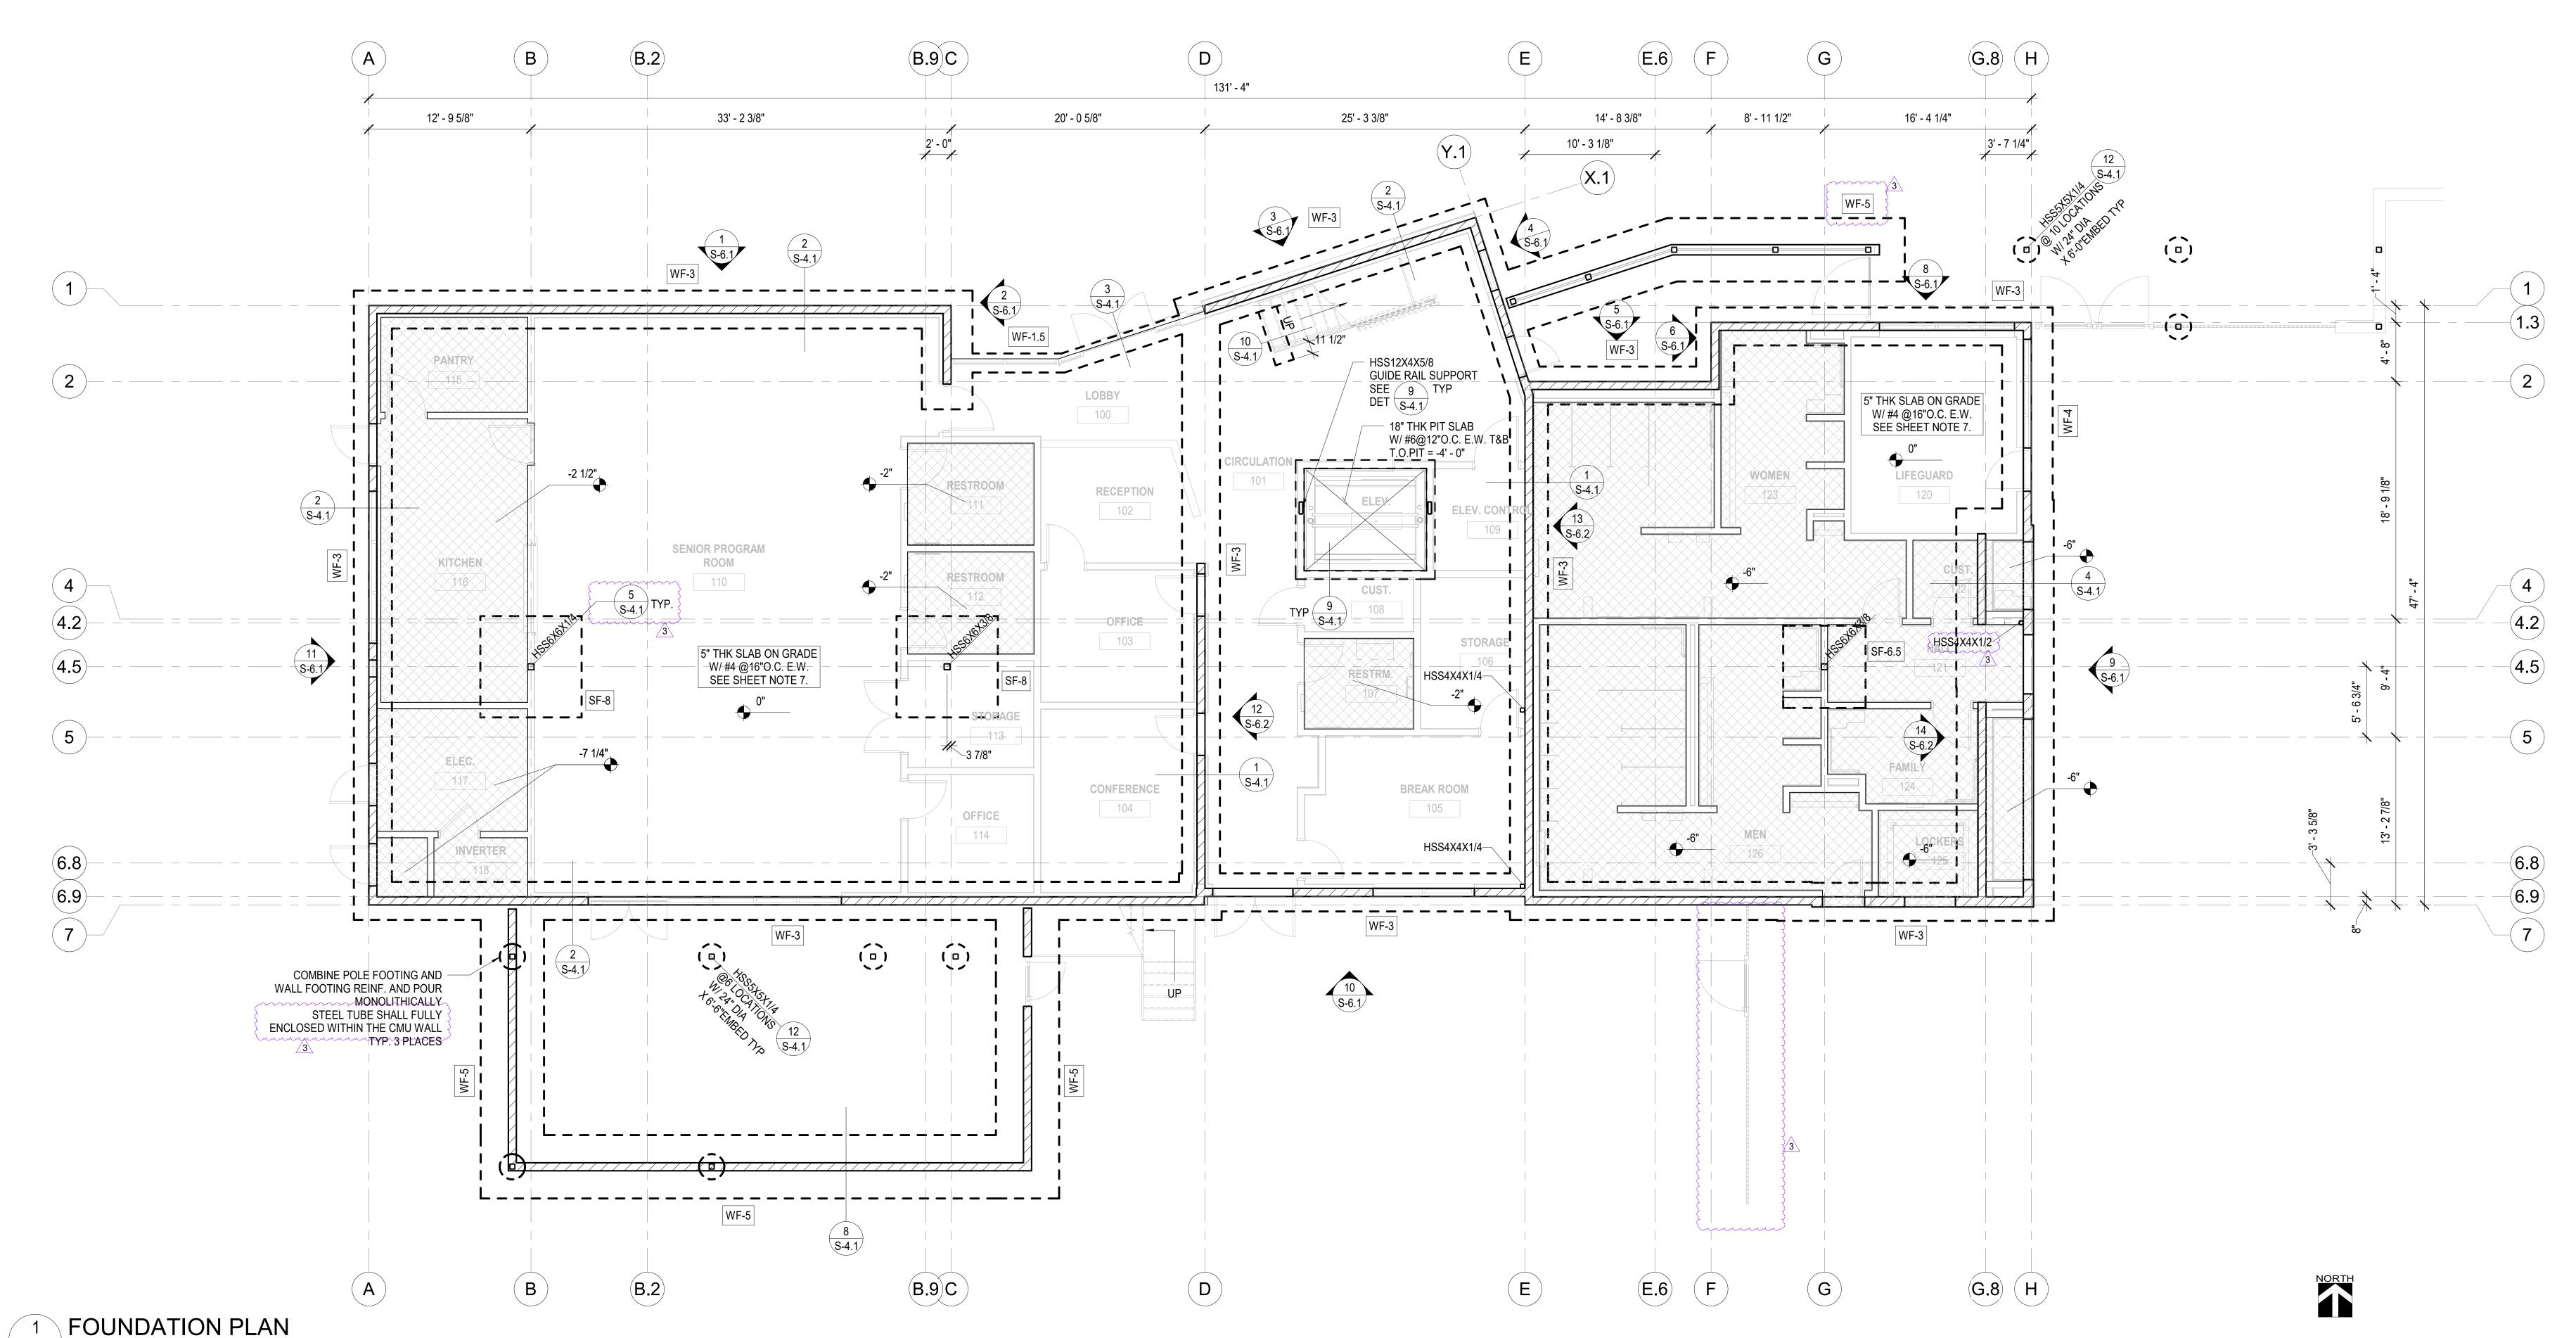

S-2.1 SCALE: 3/16" = 1'-0" REF DET:1 / S-6.1





REVISIONS

OCITY OF GARDENA
DEPARTMENT OF PUBLIC WORKS - ENGINEERING

FOUNDATION PLAN

1 90%CD SUBMITTAL 12/15/2022
2 100%CD SUBMITTAL 05/01/2023
3 ADDENDUM #3 08/25/2023
COMMUNITY AQUATICS & SENIOR CENTER
S-2.1

DIRECTOR OF PUBLIC WORKS

5-2606

SHT. 100 OF 176

B.M.: THE CITY OF GARDENA BENCHMARK NO. 5D-15

ELEV. = 43.508'

FLOOR FRAMING NOTES: 1. FOR GENERAL NOTES, SEE S-00# SERIES.

2. FOR TYPICAL DETAILS, SEE S-1## SERIES, SEE REFERENCES BELOW. 3. NOT USED.

→ DECK PER DECK SCHEDULE ON THIS SHEET. SEE 2 / S-1.8 FOR ADDITIONAL INFORMATION.

5. SEE PLAN FOR T.O.S. NOTE, COORDINATE T.O.S. NOTED WITH ARCHITECTURAL DRAWINGS

6. FOR TYPICAL BEAM TO BEAM CONNECTIONS, SEE DETAIL LEGEND.

CANTILEVER BEAM MOMENT
CONNECTION SEE DETAIL 1 / S-1.12

8. COLUMNS: SEE FLOORS BELOW FOR SIZES NOT NOTED HERE IN.

─**||** BEAM SPLICE. SEE DETAIL 15 / S-1.10 & 11 / S-1.11

INDICATES BOLT CONNECTION AT SLRS SEE DETAIL 12 / S-1.10 BEAMS WITH THIS SYMBOL ARE PART OF THE SLRS.

INDICATES (2) ROWS OF A490SC, ●● NDICATES (1) ROW OF A490SC,

S-3.1 SCALE: 3/16" = 1'-0" REF DET:1 / S-6.1

11. ALL STEEL BEAMS SHALL HAVE WELDED STUDS. SEE DETAIL 8 / S-1.11

12. AT ALL SLRS BEAMS PROVIDE BRACING @ 8' - 0" O.C. MAX PER DETAIL 4 / S-1.12

DENOTES FLOOR/ROOF PENETRATION. FOR TRIM REINF SEE DETAIL 8 / S-1.8 SEE ARCHT'L / MEP DRAWINGS FOR ACTUAL LOCATION AND ADDITION INFO AND ADDITIONAL PENETRATIONS NOT SHOWN IN THESE DRAWINGS

INDICATES DEPRESSED SLAB. SEE DETAIL 9 / S-1.1 REFER TO ARCHT'L DRAWINGS FOR ADDITIONAL INFORMATION.

NEXT TO BEAM SIZE INDICATES LOWERED BEAM AROUND DEPRESSED AREA * SEE 7 / S-1.11 FOR BEAM WITH WT SECTION. NOTE: DOUBLE LINE DENOTES EXTENT OF WT.

DENOTES SLOPING METAL DECK (SLOPE PER ARCHT'L) W/ 2" LWC TOPPING SLAB W/ 6X6XD1.4XD1.4 WELDED WIRE MESH OVER WATERPROOFING OVER SCREEDING LAYER. FOR TYP SECTION SEE ARCHT'L DETAIL x/A-x

17. ALL LEDGERS (C12x) ARE PART OF THE SLRS.

DECK SCHEDULE GAGE I (IN4/FT) S (TOP +) S (BOT -) TOTAL CONC FILL (IN3/FT) (IN3/FT) DEPTH(IN) TYPE DECK MARK ATTACHMENT PATTERN SIDE-SEAM ATTACHMENT #3 @ 12" O/C | 3/4 DIA. X 4 1/2" FN HT | TOP SEAM WELD VERCO W2 18 0.564 0.471 0.481 5" LWC 36/4 IAPMO 2018 @ 24" O/C E.W. HSB 36 IAPMO 2018 TOP SEAM WELD 18 0.306 0.314 0.331 1 1/2" BARE @ 6" O/C #3 @ 12" O/C | 3/4 DIA. X 4 1/2" FN HT | TOP SEAM WELD VERCO HSB-36 18 0.302 0.314 0.401 1.5" 36/4 IAPMO 2018 @ 12" O/C @ 24" O/C E.W. VERCO 2.0D IAPMO 2018 #3 @ 12" O/C 3/4 DIA. X 4 1/2" FN HT TOP SEAM WELD 18 0.792 0.587 0.576

LWC

E.W.

@ 12" O/C

@ 24" O/C

TYPICAL BM TO BM & BM TO COL. LEGEND SLRS BEAM -WF BEAM
WHERE OCCURS PER PLAN 12 S-1.10 △ WFBM S-1.10 S-1.12 WF BEAM TYP WHERE OCCURS PER PLAN S-1.10 - WF BEAM WHERE OCCURS

	A	B.2	B.9C	D	E	E.6 F G	(G.8) (H)		
1 1.3 2 4 4.2 4.5 5 	W12X19 EQ W12X19 EQ W12X19 PROG W12X19 W12X19 W12X19 W12X19 W12X19 W12X19 W12X19 W12X19 W12X19 W12X19	TO SEE A SEE	(P	12X 19	W12X19 W12X19	S-1. S-1. S-1.	TYP HSS HSS10X2X1/4 CONT TYP HSS HSS10X2X1/4 CONT W12X19 EQ EQ W12X19 TYP HSS HSS10X2X1/4 CONT W12X19 TO HSS HSS10X2X1/4 CONT W8X35 TO HSS10X2X1/4 CONT W8X35	HATCHED AREA DENOTES	1.3 - (2) 4 4.2 - (4.5) - (5)
7	A	HSS10X4X1/4 TYP HSS10X2X1/4 CONT B B.2	HSS10X2X1/4 CONT 2X8 TRLLIS INFILL MEMBERS PER ARCHT'L TYP		2 S-5.1)	W8X21	HSS4X4X1/4 C12X20.7 (ABV) W8X15 T.O.C.= 12'-8	NORTH	7
1 2ND FLOOR FRAMI									



CITY OF GARDENA REVISIONS DEPARTMENT OF PUBLIC WORKS - ENGINEERING SECOND FLOOR FRAMING PLAN
 90%CD SUBMITTAL
 12/15/2022

 100%CD SUBMITTAL
 05/01/2023

 ADDENDUM #3
 08/25/2023
 COMMUNITY AQUATICS & SENIOR CENTER

DIRECTOR OF PUBLIC WORKS

B.M.: THE CITY OF GARDENA BENCHMARK NO. 5D-15 ELEV. = 43.508' SHT. 102 OF 176 DWG. NO. 5-2606